

Lincoln
P
2038

MISSISSIPPI
BOARD OF WATER COMMISSIONERS
416 North State Street
Jackson, Mississippi 39201

WATER WELL DRILLERS LOG

March 23 1982 Brumfield Well Serv. Lincoln
date well completed firm name county well located

LANDOWNER: LARRY SASSER
Pt # 3
Bogue Chitto Miss.
(mailing address)

WELL LOCATION:
sec. 7 T 5 N R 7 E
4 miles W Bogue Chitto
(distance) (direction) (nearest town)

WELL PURPOSE: Home
(home, irrigation, municipal, industrial)

WELL COMPLETION DATA:
(1) diameter (inches) 4"
(2) total depth (feet) 39
(3) static water level (feet) 19' below top of ground
(4) casing (material) (depth) 4" if telescope see back.
(5) screen (length) (depth to top) 10' 29' PLASTIC
(6) pump (HP) (yield gpm) 1/2 HP 3 1/2
electric
(type power)
(7) electric log NO
(yes or no)
(organization running log)
(8) how well bottom plugged SAND SHAW


description of formations encountered	from	to
TOP Soil and		
CLAY	0	4
CLAY Concret	4	12
SAND + GRAVEL	12	18
SAND + ROCK	18	19
WATER SAND	19	22
CLAY + SAND	22	28
SAND + ROCK	28	29
WATER SAND + ROCK	29	39
FLINT ROCK		39'

MISSISSIPPI DEPARTMENT OF NATURAL RESOURCES
BUREAU OF LAND & WATER RESOURCES
APR 27 1982
RECEIVED

DRILLERS REMARKS:

If well telescopes please sketch and show depths.

GROUND LEVEL

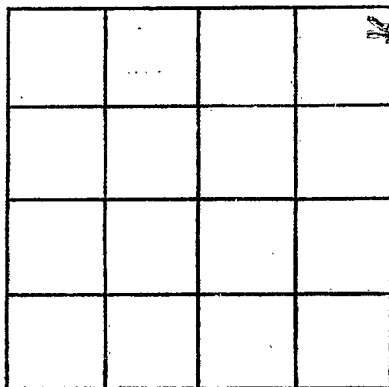

SECTION _____

Please indicate well location X.

ADDITIONAL INFORMATION

If more than one screen,
show locations of each on sketch.