

Lincoln
P
2040

MISSISSIPPI
BOARD OF WATER COMMISSIONERS
416 North State Street
Jackson, Mississippi 39201

WATER WELL DRILLERS LOG

5-19 1982 Brunfield well serv Lincoln
date well completed firm name county well located

LANDOWNER: Tim Sasser
Rt. 3
Bogue Chitto ms.
(mailing address)

description of formations encountered	from	to
Surface Clay	0	16
Sandy clay	16	35
Sand	35	50
Blue clay	50	78
Sand + Rock	78	96

WELL LOCATION:
sec. 10 T 5 N R 7 E
3 miles SW of B.C.
(distance) (direction) (nearest town)

WELL PURPOSE: Home
(home, irrigation, municipal, industrial)

- WELL COMPLETION DATA:
- (1) diameter (inches) 4
 - (2) total depth (feet) 90
 - (3) static water level (feet) 54 below top of ground.
 - (4) casing Plastic 80'
(material) (depth)
 - 4 If telescope see back.
(size)
 - (5) screen 10' 80'
(length) (depth to top)
 - 4" Plastic
(size) (material)
 - (6) pump 1/2 sub 10
(HP) (yield gpm)
 - Electric
(type power)
 - (7) electric log no
(yes or no)

(organization running log)
(8) how well bottom plugged Sand shark


DRILLERS REMARKS:

DEPT. OF NATURAL RESOURCES
BUREAU OF LAND & WATER RESOURCES

JUN - 8 1982
RECEIVED

If well telescopes please sketch and show depths.

GROUND LEVEL

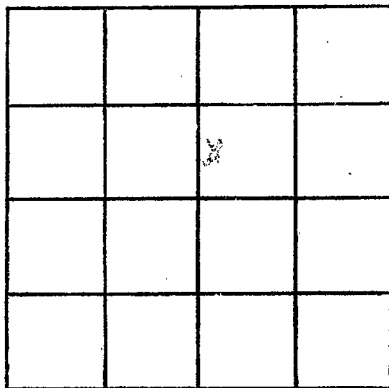

SECTION 10

Please indicate well location X.

ADDITIONAL INFORMATION

If more than one screen, show locations of each on sketch.