

Lincoln
P
2041

MISSISSIPPI DEPARTMENT OF NATURAL RESOURCES
 Bureau of Land and Water Resources
 Southport Mall
 P.O. Box 10631
 Jackson, Mississippi 39209
WATER WELL DRILLERS LOG

May 28 1982 Grenn Water Well Lincoln
 date well completed firm name county well located

LANDOWNER: Benton Burt
852 W. Congress
Brookhaven, Ms.
 (mailing address)

description of formations encountered
Citronelle from 1 to 129

WELL LOCATION:
 sec. 6 T 5 N R 7 E
6 miles West of Bogue Chitto
 (distance) (direction) (nearest town)

WELL PURPOSE: home
 (home, irrigation, municipal, industrial)

- WELL COMPLETION DATA:
- (1) diameter (inches) 4
 - (2) total depth (feet) 129
 - (3) static water level (feet) 61 below above top of ground.
 - (4) casing PVC, 119,
 (material) (depth)
4" if telescope see back.
 (size)
 - (5) screen 10', 119
 (length) (depth to top)
.010, PVC
 (size) (material)
 - (6) pump did not install
 (HP) (yield gpm)
 - (type power)
 - (7) electric log no
 (yes or no)
 - (organization running log)
 - (8) how well bottom plugged back wash valve

DRILLERS REMARKS:


DEPT. OF NATURAL RESOURCES
 BUREAU OF LAND & WATER RESOURCES

III - 1 1982

RECEIVED

If well telescopes please sketch and show depths.

GROUND LEVEL

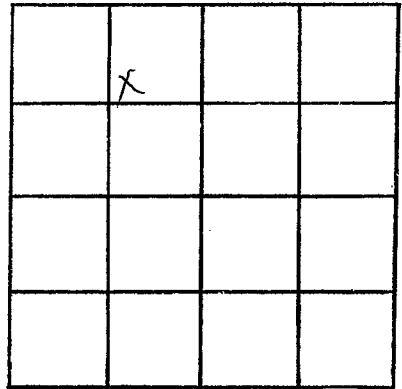

SECTION 6

Please indicate well location X.

ADDITIONAL INFORMATION

If more than one screen,
show locations of each on sketch.