

Lincoln
P 2042

MISSISSIPPI DEPARTMENT OF NATURAL RESOURCES
Bureau of Land and Water Resources
Southport Mall
P.O. Box 10631
Jackson, Mississippi 39209
WATER WELL DRILLERS LOG

July 30 19 82 Gretn Water Well Lincoln
date well completed firm name county well located

LANDOWNER: H.D. Barton
Route 3, Box 126
Bogue Chitto, Ms.
(mailing address)

description of formations encountered
Citronelle
from 1 to 118

WELL LOCATION:
sec 32 T 5 N R 7 E
S W
6 miles SW of Bogue Chitto
(distance) (direction) (nearest town)

WELL PURPOSE: home
(home, irrigation, municipal, industrial)

WELL COMPLETION DATA:

(1) diameter (inches) 4

(2) total depth (feet) 118

(3) static water level (feet) 66 below
top of ground.

(4) casing PVC 108
(material) (depth)
4"
(size) If telescope see back.

(5) screen 10' 108'
(length) (depth to top)
.010 PVC
(size) (material)

(6) pump 1/2 sub 8
(HP) (yield gpm)
electricity
(type power)

(7) electric log no
(yes or no)
(organization running log)


(8) how well bottom plugged back wash valve

DRILLERS REMARKS:

DEPT. OF NATURAL RESOURCES
BUREAU OF LAND & WATER RESOURCES
SEP 30 1982
RECEIVED

If well telescopes please sketch and show depths.

GROUND LEVEL

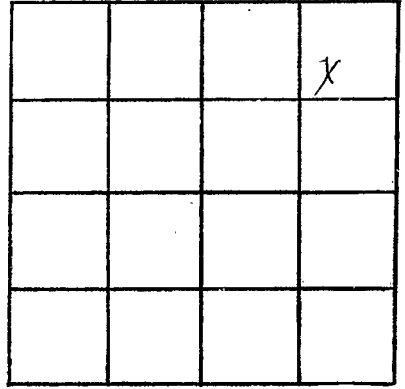

SECTION 32

Please indicate well location X.

ADDITIONAL INFORMATION

If more than one screen,
show locations of each on sketch.