

Lincoln
P
2043

MISSISSIPPI DEPARTMENT OF NATURAL RESOURCES
 Bureau of Land and Water Resources
 Southport Mall
 P.O. Box 10631
 Jackson, Mississippi 39209
WATER WELL DRILLERS LOG

Lincoln
Richie

Aug 10 1982
 date well completed

Reynoldsville
 firm name

county well located

LANDOWNER:

Rev. John H. Thomas

At Summit

(mailing address)

WELL LOCATION:

sec. 35 T 2 N R 2 E

6 miles South of Summit
 (distance) (direction) (nearest town)

WELL PURPOSE:

Camp
 (home, irrigation, municipal, industrial)

WELL COMPLETION DATA:

- (1) diameter (inches) 4"
- (2) total depth (feet) 70
- (3) static water level (feet) 50' below above top of ground.
- (4) casing Aluminum batton
 (material) (depth)
- (5) screen 5' 65'
 (length) (depth to top)
- (6) pump 4" plastic
 (size) (material)
- (7) pump 1/2 HP 10 gpm
 (type power) (yield gpm)
- (8) electric log no
 (yes or no)

(organization running log)

(8) how well bottom plugged

back using

DRILLERS REMARKS:

description of formations encountered

from

to

<u>Clay</u>	<u>0</u>	<u>15</u>
<u>brown sand</u>	<u>15</u>	<u>45</u>
<u>sandResp</u>	<u>45</u>	<u>46</u>
<u>pink Chalk</u>	<u>46</u>	<u>52</u>
<u>sand & peag sand</u>	<u>52</u>	<u>70</u>


DEPT. OF NATURAL RESOURCES
 BUREAU OF LAND & WATER RESOURCES

JAN 18 1983

RECEIVED

If well telescopes please sketch and show depths.

GROUND LEVEL

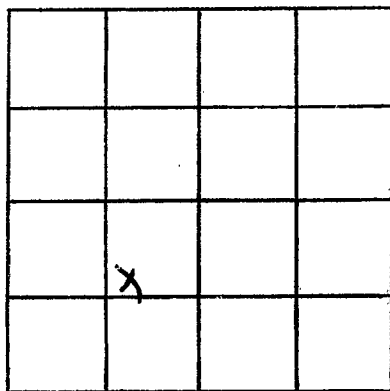

SECTION 35

Please indicate well location X.

ADDITIONAL INFORMATION

If more than one screen, show locations of each on sketch.