

MISSISSIPPI DEPARTMENT OF NATURAL RESOURCES
 Bureau of Land and Water Resources
 Southport Mall
 P.O. Box 10631
 Jackson, Mississippi 39209
WATER WELL DRILLERS LOG

Lincoln
P
2044

Oct. 25 1982 Green Water Well Lincoln
 date well completed firm name county well located


LANDOWNER:	description of formations encountered	from	to
Dub McCaffery Rt. 3, Box 339 Bogue Chitto, Ms. (mailing address)			
WELL LOCATION:			
sec. <u>11</u> T. <u>5</u> N R. <u>7</u> E S W			
<u>3</u> miles SW of <u>Bogue Chitto</u> (distance) (direction) (nearest town)			
WELL PURPOSE: <u>Home</u> (home, irrigation, municipal, industrial)			
WELL COMPLETION DATA:			
(1) diameter (inches) <u>4</u>			
(2) total depth (feet) <u>85</u>			
(3) static water level (feet) <u>63</u> below above top of ground.			
(4) casing <u>PVC</u> <u>75</u> (material) (depth)			
<u>4"</u> (size) if telescope see back.			
(5) screen <u>10'</u> <u>75'</u> (length) (depth to top)			
<u>.010</u> <u>PVC</u> (size) (material)			
(6) pump <u>did not install</u> (HP) (yield gpm)			
<u></u> (type power)			
(7) electric log <u>no</u> (yes or no)			
<u></u> (organization running log)			
(8) how well bottom plugged <u>back wash valve</u>			

DRILLERS REMARKS:

DEPT. OF NATURAL RESOURCES
 BUREAU OF LAND & WATER RESOURCES
 NOV 23 1982
RECEIVED

If well telescopes please sketch and show depths.

GROUND LEVEL

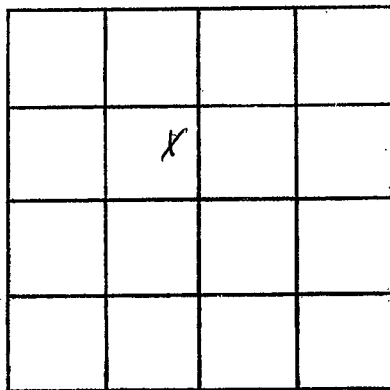

SECTION //

Please indicate well location X.

ADDITIONAL INFORMATION

If more than one screen,
show locations of each on sketch.