

Lincoln
P
2048

MISSISSIPPI DEPARTMENT OF NATURAL RESOURCES
 Bureau of Land and Water Resources
 Southport Mall
 P.O. Box 10631
 Jackson, Mississippi 39209
WATER WELL DRILLERS LOG

5-10 1983 Fitzgerald Well Serv Lincoln
 date well completed firm name county well located

LANDOWNER:
Clyde Cain
R.R. Sommitt, Mo.
 (mailing address)

description of formations encountered	from	to
<u>Red Clay</u>	<u>0</u>	<u>20</u>
<u>Red Sand</u>	<u>20</u>	<u>50</u>
<u>White Chalk</u>	<u>50</u>	<u>160</u>
<u>Coarse Sand & gravel</u>	<u>160</u>	<u>168</u>

WELL LOCATION:
 sec. 32 5 N 7 E
 S W
8 miles NNW of Summit
 (distance) (direction) (nearest town)

WELL PURPOSE: Home
 (home, irrigation, municipal, industrial)

- WELL COMPLETION DATA:
- (1) diameter (inches) 4
 - (2) total depth (feet) 168
 - (3) static water level (feet) 75 below above top of ground.
 - (4) casing NVC, 160,
 (material) (depth)
4 if telescope see back.
 (size)
 - (5) screen 8, 160
 (length) (depth to top)
4, NVC
 (size) (material)
 - (6) pump 1/2, 10
 (HP) (yield gpm)
elec
 (type power)
 - (7) electric log no
 (yes or no)
 (organization running log)
 - (8) how well bottom plugged Sand Sh

DRILLERS REMARKS:


DEPT. OF NATURAL RESOURCES
 BUREAU OF LAND & WATER RESOURCES

JUL 11 1983

RECEIVED

If well telescopes please sketch and show depths.

GROUND LEVEL

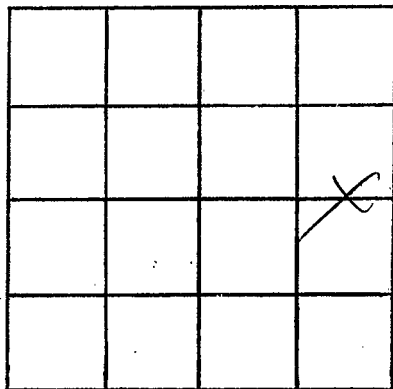

SECTION 32

Please indicate well location X.

ADDITIONAL INFORMATION

If more than one screen,
show locations of each on sketch.