

MISSISSIPPI DEPARTMENT OF NATURAL RESOURCES

Bureau of Land and Water Resources

Southport Mall

P.O. Box 10631

Jackson, Mississippi 39209

WATER WELL DRILLERS LOG

<i>Lincoln</i>
<i>P</i>
<i>2050</i>

*Aug 6* 19 *83* *Acme Well Dr* *Lincoln*  
 date well completed firm name county well located

LANDOWNER:	description of formations encountered	from	to
<i>Acme Well Dr</i> <i>At Summit</i> (mailing address)			
	<i>Red sand</i>	<i>17</i>	<i>48</i>
	<i>sand &amp; gravel</i>	<i>48</i>	<i>62</i>
	<i>lumpy</i>	<i>62</i>	<i>95</i>
	<i>sand &amp; gravel</i>	<i>95</i>	<i>112</i>
WELL LOCATION: sec. <i>21</i> T <i>5</i> N R <i>7</i> E <i>6</i> miles <i>n</i> of <i>Summit</i> (distance) (direction) (nearest town)			
WELL PURPOSE: <i>drinking</i> (home, irrigation, municipal, industrial)			
WELL COMPLETION DATA: (1) diameter (inches) <i>4"</i> (2) total depth (feet) <i>112</i> (3) static water level (feet) <i>50</i> below top of ground. (4) casing <i>plastic bottom</i> (material) (depth) <i>7</i> if telescope see back. (size) (5) screen <i>5'</i> <i>107</i> (length) (depth to top) <i>4"</i> <i>plastic</i> (size) (material) (6) pump <i>3/4</i> <i>10</i> (HP) (yield gpm) <i>West</i> (type power) (7) electric log <i>no</i> (yes or no) (organization running log) (8) how well bottom plugged <i>back wash</i> DRILLERS REMARKS:			


DEPT. OF NATURAL RESOURCES  
BUREAU OF LAND & WATER RESOURCES

DEC - 7 1983

RECEIVED

If well telescopes please sketch and show depths.

GROUND LEVEL

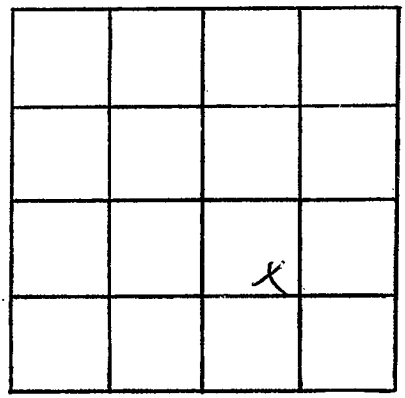

SECTION 21

Please indicate well location X.

ADDITIONAL INFORMATION

Lined area for additional information, consisting of approximately 20 horizontal lines.

If more than one screen, show locations of each on sketch.