

MISSISSIPPI DEPARTMENT OF NATURAL RESOURCES

Bureau of Land and Water Resources

Southport Mall

P.O. Box 10631

Jackson, Mississippi 39209

WATER WELL DRILLERS LOG

Lindon
P
2057

10-10
date well completed

1983

Fitzgerald well serv
firm name

Lindon
county well located

LANDOWNER:	description of formations encountered	from	to
<i>James May</i> <i>P.B. Bogue, Little, Mrs.</i> (mailing address)	<i>Red clay</i> <i>Red sand</i> <i>Coarse sand gravel</i>	<i>0</i> <i>20</i> <i>60</i>	<i>20</i> <i>60</i> <i>85</i>
WELL LOCATION: sec. <i>29</i> T- <i>5</i> N R- <i>7</i> E S W <i>6 1/2</i> miles <i>NNW</i> of <i>Summit</i> (distance) (direction) (nearest town)			
WELL PURPOSE: (home, irrigation, municipal, industrial) <i>Home</i>			
WELL COMPLETION DATA:			
(1) diameter (inches) <i>4</i>			
(2) total depth (feet) <i>85</i>			
(3) static water level (feet) <i>60</i> below top of ground.			
(4) casing <i>PVC</i> , <i>77</i> , (material) (depth) <i>4</i> if telescope see back. (size)			
(5) screen <i>8</i> , <i>77</i> (length) (depth to top)			
(6) pump <i>1/2</i> , <i>PVC</i> (HP) (material)			
(7) electric log <i>no</i> (yes or no) <i>Land Star</i> (organization running log)			
(8) how well bottom plugged <i>Land Star</i>			
DRILLERS REMARKS:			


DEPT. OF NATURAL RESOURCES
BUREAU OF LAND & WATER RESOURCES

DEC - 9 1983

RECEIVED

If well telescopes please sketch and show depths.

GROUND LEVEL

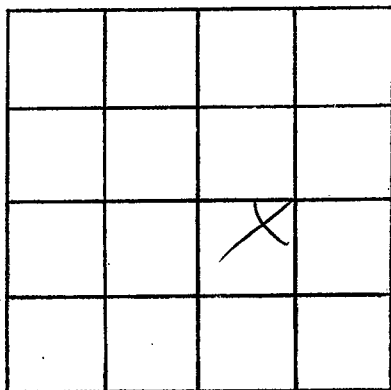

SECTION 29

Please indicate well location X.

ADDITIONAL INFORMATION

If more than one screen,
show locations of each on sketch.