

MISSISSIPPI DEPARTMENT OF NATURAL RESOURCES

Bureau of Land and Water Resources

Southport Mall

P.O. Box 10631

Jackson, Mississippi 39209

WATER WELL DRILLERS LOG

| |
|----------------|
| <i>Lincoln</i> |
| <i>P</i> |
| <i>2053</i> |

July 31 1984 Grenn Water Well Lincoln
 date well completed firm name county well located


| LANDOWNER: Grover Wallace Rt. 3, Box 96 Bogue Chitto, Ms. (mailing address) | description of formations encountered Citronelle | from 1 | to 118 |
|---|---|-----------|-----------|
| WELL LOCATION: sec. 20 T 5 N R 7 E S W 5 miles SW of Bogue Chitto (distance) (direction) (nearest town) | | | |
| WELL PURPOSE: home (home, irrigation, municipal, industrial) | | | |
| WELL COMPLETION DATA: (1) diameter (inches) 4 (2) total depth (feet) 118 (3) static water level (feet) 49 below above top of ground. (4) casing PVC, 108', (material) (depth) 4" if telescope see back. (size) (5) screen 10', 108', (length) (depth to top) .010 PVC (size) (material) (6) pump 1/2 sub 8 (HP) (yield gpm) electricity (type power) (7) electric log no (yes or no) (organization running log) (8) how well bottom plugged back wash valve | | | |

MISSISSIPPI DEPARTMENT OF NATURAL RESOURCES
 BUREAU OF LAND & WATER RESOURCES
 SEP 18 1984
 RECEIVED

DRILLERS REMARKS:

If well telescopes please sketch and show depths.

GROUND LEVEL

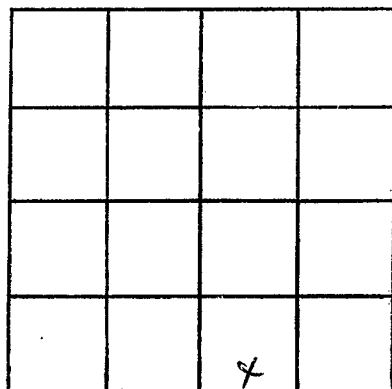

SECTION 20

Please indicate well location X.

ADDITIONAL INFORMATION

If more than one screen,
show locations of each on sketch.