

Lincoln
P
2055

MISSISSIPPI DEPARTMENT OF NATURAL RESOURCES
Bureau of Land and Water Resources
Southport Mall
P.O. Box 10631
Jackson, Mississippi 39209
WATER WELL DRILLERS LOG

9-21 84 Grenn Water Well Lincoln
date well completed firm name county well located

LANDOWNER: Bill Brown
Rt, 3, Box 62
Bogue Chitto, Ms.
(mailing address)

description of formations encountered	from	to
Citronelle	1	82

WELL LOCATION:
sec 14 T 5 N R 7 E
S W
3 miles S of Bogue Chitto
(distance) (direction) (nearest town)

WELL PURPOSE: home
(home, irrigation, municipal, industrial)

- WELL COMPLETION DATA:
- (1) diameter (inches) 4
 - (2) total depth (feet) 82
 - (3) static water level (feet) 48 below above top of ground.
 - (4) casing PVC 72
(material) (depth)
4" if telescope see back.
(size)
 - (5) screen 10' 72'
(length) (depth to top)
.010 PVC
(size) (material)
 - (6) pump 1/2 sub 8
(HP) (yield gpm)
electricity
(type power)
 - (7) electric log no
(yes or no)
(organization running log)
 - (8) how well bottom plugged
back wash valve

DEPT. OF NATURAL RESOURCES
BUREAU OF LAND & WATER RESOURCES


NOV 15 1984

RECEIVED

DRILLERS REMARKS:

If well telescopes please sketch and show depths.

GROUND LEVEL

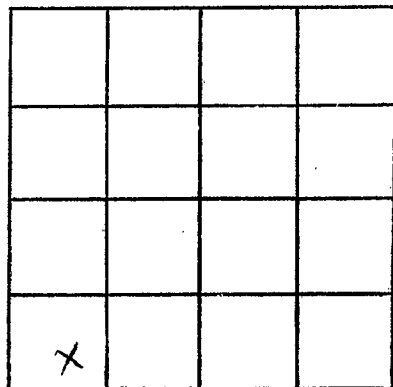

SECTION 14

Please indicate well location X.

ADDITIONAL INFORMATION

If more than one screen,
show locations of each on sketch.