

MISSISSIPPI DEPARTMENT OF NATURAL RESOURCES

Bureau of Land and Water Resources

Southport Mall

P.O. Box 10631

Jackson, Mississippi 39209

WATER WELL DRILLERS LOG

LINCOLN
P
2050

Sept 11

19

\$5 Renew Mill Ln

Lincoln

date well completed

firm name

county well located

LANDOWNER:
Oscar Gattin
Mt Summit
(mailing address)

description of formations encountered

from

to

| | | |
|---------------|----|-----|
| Red Clay | 0 | 17 |
| Red sand | 17 | 55 |
| soft gravel | 55 | 75 |
| hardly sand | 75 | 90 |
| gravel & sand | 90 | 102 |


WELL LOCATION:

sec. 28 T 5 N R 7 E
5 miles north of Summit
(distance) (direction) (nearest town)

WELL PURPOSE: house
(home, irrigation, municipal, industrial)

WELL COMPLETION DATA:

- (1) diameter (inches) 4"
- (2) total depth (feet) 102
- (3) static water level (feet) 70 below top of ground.
- (4) casing plastic bottom
(material) (depth)
- if telescope see back.
(size)
- (5) screen 5' 99'
(length) (depth to top)
- 4" plastic
(size) (material)
- (6) pump by others
(HP) (yield gpm)
- shot
(type power)
- (7) electric log no
(yes or no)
- (organization running log)

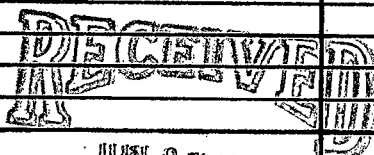

JUL 27 1980


Department of Natural Resources
Bureau of Land & Water Resources

(8) how well bottom plugged
back wash

DRILLERS REMARKS:

If well telescopes please
sketch and show depths.

GROUND LEVEL

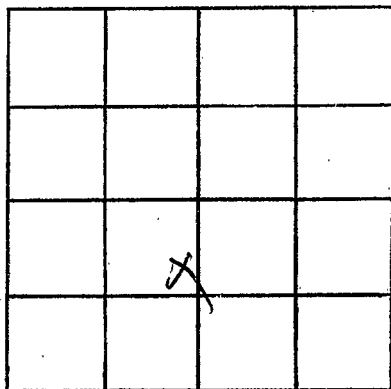

SECTION 28

Please indicate well location X.

ADDITIONAL INFORMATION

If more than one screen,
show locations of each on sketch.