

**MISSISSIPPI DEPARTMENT OF NATURAL RESOURCES**  
**Bureau of Land and Water Resources**  
 Southport Mall  
 P.O. Box 10631  
 Jackson, Mississippi 39209  
**WATER WELL DRILLERS LOG**

LINCOLN
P
2057

May 19 19 86 Grenn Water Well Lincoln  
 date well completed firm name county well located

<b>LANDOWNER:</b> Hilar Lee Clark	description of formations encountered	from	to
Route 4			
Bogue Chitto, Ms. (mailing address)			
<b>WELL LOCATION:</b>			
sec. 3 T 5 N R 7 E S W			
2 miles SW of Bogue Chitto (distance) (direction) (nearest town)			
<b>WELL PURPOSE:</b> home (home, irrigation, municipal, industrial)			
<b>WELL COMPLETION DATA:</b>			
(1) diameter (inches) 4"			
(2) total depth (feet) 72"			
(3) static water level (feet) 58' below top of ground.			
(4) casing PVC, 62' (depth) 4" (size) if telescope see back.			
(5) screen 10' (length), 62' (depth to top) .010 (size), PVC (material)			
(6) did not install pump (HP) (yield gpm) (type power)			
(7) electric log no (yes or no) (organization running log)			
(8) how well bottom plugged back wash valve			


**RECEIVED**  
 JUN 27 1986

Department of Natural Resources  
 Bureau of Land & Water Resources

**DRILLERS REMARKS:**

If well telescopes please sketch and show depths.

GROUND LEVEL

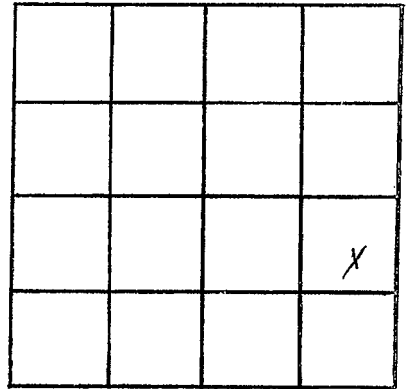

SECTION 3

Please indicate well location X.

ADDITIONAL INFORMATION

If more than one screen,  
show locations of each on sketch.