

MISSISSIPPI DEPARTMENT OF NATURAL RESOURCES

Bureau of Land and Water Resources

Southport Mall


P.O. Box 10631

Jackson, Mississippi 39209

WATER WELL DRILLERS LOG


LINCOLN
P
2059

8-41-1986 date well completed Stallard Waterwell firm name Lincoln county well located

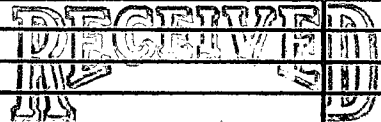LANDOWNER: <u>Robert Herring</u> <u>Rd 3</u>	description of formations encountered	from	to
<u>Boyer Chittin, Ms 39624</u> (mailing address)	<u>top soil</u>	0	1'
WELL LOCATION: sec. <u>28</u> T <u>S</u> R <u>7</u> E 10 miles <u>N. N.W.</u> of <u>Summitt</u> (distance) (direction) (nearest town)	<u>brown clay</u>	1'	4'
WELL PURPOSE: <u>home</u> (home, irrigation, municipal, industrial)	<u>sand</u>	4'	22'
WELL COMPLETION DATA: (1) diameter (inches) <u>4"</u> (2) total depth (feet) <u>69'</u> (3) static water level (feet) <u>15</u> ^{below} / _{above} top of ground. (4) casing <u>plastic</u> , <u>69'</u> (material) (depth) (size) If telescope see back. (5) screen <u>10'</u> , <u>59'</u> (length) (depth to top) <u>4"</u> , <u>plastic</u> (size) (material) (6) pump <u>1/2</u> , <u>11</u> (HP) (yield gpm) <u>electric</u> (type power) (7) electric log _____ (organization running log) (8) how well bottom plugged, <u>AND</u> <u>SHANK</u>	<u>course sand & gravel</u>	22'	69'
DRILLERS REMARKS:	 <p>DEC 1986</p> <p>Department of Natural Resources Bureau of Land & Water Resources</p>		

If well telescopes please sketch and show depths.

GROUND LEVEL

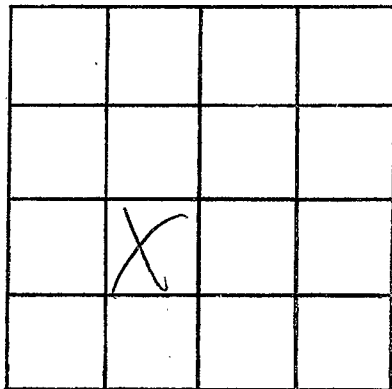

SECTION 28

Please indicate well location X.

ADDITIONAL INFORMATION

If more than one screen,
show locations of each on sketch.