

MISSISSIPPI DEPARTMENT OF NATURAL RESOURCES
Bureau of Land and Water Resources
 Southport Mall
 P.O. Box 10631
 Jackson, Mississippi 39209
WATER WELL DRILLERS LOG

Lincoln
P
2060

Jan. 22, 19 86 Grenn Water Well Lincoln
 date well completed firm name county well located

LANDOWNER: Roger Moak
 Rt. 3, Box 302M
 Bogue Chitto, Ms.
 (mailing address)

description of formations encountered	from	to
	Citronelle	1

WELL LOCATION:

sec. 9 T. 5 N. R. 7 E
 S W
3 miles SW of Bogue Chitto
 (distance) (direction) (nearest town)

WELL PURPOSE: home
 (home, irrigation, municipal, industrial)

WELL COMPLETION DATA:

- (1) diameter (inches) 4
- (2) total depth (feet) 142
- (3) static water level (feet) 72 below above top of ground.
- (4) casing PVC 132
 (material) (depth)
- 4
 (size) if telescope see back.
- (5) screen 10' 132'
 (length) (depth to top)
.010 PVC
 (size) (material)
- (6) pump 1/2 sub 10
 (HP) (yield gpm)
- electricity
 (type power)
- (7) electric log no
 (yes or no)

(organization running log)

(8) how well bottom plugged
back wash valve


DRILLERS REMARKS:

DISCOVERED
RESOURCES
 FEB 20 1986

Department of Natural Resources
 Bureau of Land & Water Resources

If well telescopes please
sketch and show depths.

GROUND LEVEL

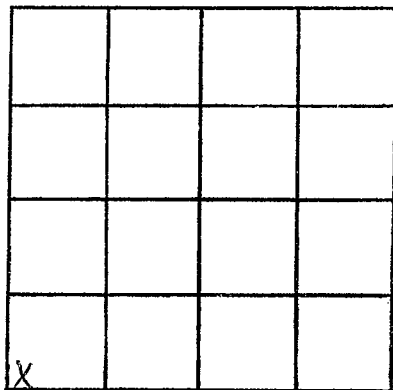

SECTION 9

Please indicate well location X.

ADDITIONAL INFORMATION

If more than one screen,
show locations of each on sketch.