

MISSISSIPPI DEPARTMENT OF NATURAL RESOURCES

Bureau of Land and Water Resources

Southport Mall

P.O. Box 10631

Jackson, Mississippi 39209

WATER WELL DRILLERS LOG

LINCOLN
P
2061

2-19

date well completed

1986

Fitzgerald Well Serv

firm name

Lincoln

county well located

LANDOWNER:	description of formations encountered	from	to
Bill Johnson R.R. Summit ms. (mailing address)			
WELL LOCATION: sec <u>34</u> T. <u>5</u> N R. <u>7</u> E S W <u>6</u> miles <u>NNW</u> of <u>Summit</u> (distance) (direction) (nearest town)			
WELL PURPOSE: <u>Home</u> (home, irrigation, municipal, industrial)			
WELL COMPLETION DATA:			
(1) diameter (inches) <u>4</u>			
(2) total depth (feet) <u>109</u>			
(3) static water level (feet) <u>30</u> below top of ground.			
(4) casing <u>PVC</u> , <u>99</u> (material), (depth) <u>4</u> (size) if telescope see back.			
(5) screen <u>10</u> , <u>99</u> (length), (depth to top) <u>4</u> , <u>PVC</u> (size), (material)			
(6) pump <u>1/2</u> , <u>10</u> (HP), (yield gpm) <u>Electric</u> (type power)			
(7) electric log <u>no</u> (yes or no) <u>Summit</u> (organization running log)			
(8) how well bottom plugged <u>Sand plug</u>			


RECEIVED  
MAR 13 1986

Department of Natural Resources  
Bureau of Land & Water Resources

DRILLERS REMARKS:

If well telescopes please  
sketch and show depths.

GROUND LEVEL

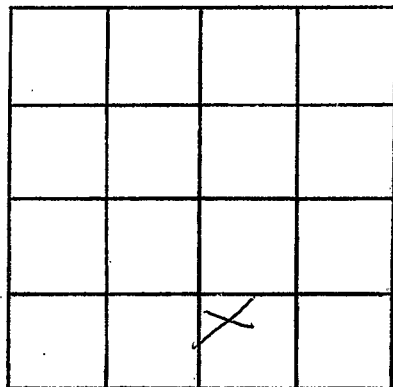

SECTION 34

Please indicate well location X.

ADDITIONAL INFORMATION

If more than one screen,  
show locations of each on sketch.