

Lincoln  
P 2067

MISSISSIPPI DEPARTMENT OF NATURAL RESOURCES  
Bureau of Land and Water Resources  
Southport Mall  
P.O. Box 10631  
Jackson, Mississippi 39209  
WATER WELL DRILLERS LOG

6-11 1987 date well completed  
Fitzgerald Well Serv Lincoln firm name county well located

LANDOWNER:  
Clint Esch  
P.O. Box 411000 (mailing address)


description of formations encountered	from	to
Red clay	0	20
fine sand	20	150
coarse sand & gravel	150	163

WELL LOCATION:  
sec. 27 T-5 N R-7 E  
6 miles N of Summit (distance) (direction) (nearest town)

WELL PURPOSE: Home (home, irrigation, municipal, industrial)

- WELL COMPLETION DATA:
- (1) diameter (inches) 4
  - (2) total depth (feet) 163
  - (3) static water level (feet) 75 below top of ground.
  - (4) casing PVC, 153 (material), (depth)  
4 (size) if telescope see back.
  - (5) screen 10 (length), 153 (depth to top)  
4 (size), PVC (material)
  - (6) pump 1/2 (HP), 10 (yield gpm)  
Elsco (type power)
  - (7) electric log No (yes or no)  
(organization running log)
  - (8) how well bottom plugged Sand plug

DRILLERS REMARKS:

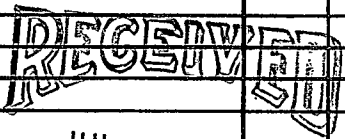


JUL 27 1987

Department of Natural Resources  
Bureau of Land & Water Resources

If well telescopes please sketch and show depths.

GROUND LEVEL

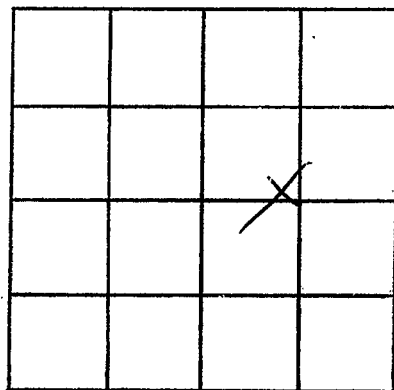

SECTION 22

Please indicate well location X.

ADDITIONAL INFORMATION

If more than one screen,  
show locations of each on sketch.