

MISSISSIPPI DEPARTMENT OF NATURAL RESOURCES

Bureau of Land and Water Resources

P.O. Box 10631

Jackson, Mississippi 39209

WATER WELL DRILLERS LOG

COUNTY WELL LOCATED
Lincoln

WELL NUMBER
P 2069

CODED

PERMIT NUMBER

DATE WELL COMPLETED
5-18-87

NAME OF DRILLING FIRM
Brenn water well & log.

NAME & MAILING ADDRESS OF LANDOWNER
Charles Duprene

Route 3 Box 88 A

Bogue Chitto, Miss.

WELL LOCATION: SEC **23** TOWNSHIP **5** RANGE **N 7 W**

DISTANCE **4** Miles DIRECTION *South* of NEAREST TOWN *Bogue Chitto*

OTHER LANDMARK

WELL PURPOSE: Home, Irrigation, Municipal, Industrial, Fish Pond, etc.
home

PUMP DATA

PUMP TYPE (Circle One): Submersible, Turbine, Jet, Flowing Well, Other (Describe) *1/2 hp*

POWER TYPE (Circle One): Electric, Tractor, Diesel, Gasoline, Butane, Other (Describe)

Pump Capacity (GPM) **10** No. of Stages **10** Setting Depth **60** FT.

PUMP TEST

Well yielded **14** GPM with a drawdown of **2** ft. after **10 min** hours of pumping

WELL DATA

Well Depth **90** Casing Diameter (In.) **4** Casing Length (Ft.) **80**

Type of Casing **PVC** Hole Depth **95** Depth to Static Water Level **40**

TYPE OF COMPLETION: (Circle One or More): Gravel Packed, Underreamed, Telescoped, Natural Development, Open Hole, Other

Top of Lap Pipe or Reduction in Casing

FEET IF TELESCOPED OR MORE THAN ONE SCREEN: USE BACK PAGE

LOG DATA

TYPE OF LOG RUN (Circle One): No Log Run, Electric, Gamma Ray, Density, Sonic, Neutron, Other (Describe)

Name of Organization Running Log

SCREEN DATA

Diameter - Inches **4** Length - Feet **10** Slot Size - Inches **.010**


Screen Type **PVC** Depth to Bottom - Feet **90**

GEOLOGIC DATA (Office Use Only)

Surface Elev.	Geologic Unit	Unit Thickness	Depth to Top
Subs. SWL	Date	Analysis	Aquifer Test

Driller's Remarks

DESCRIPTION OF FORMATIONS ENCOUNTERED	FROM	TO	FORMATIONS (continued)	FROM	TO
<i>Clay</i>		1			90
<i>Clay</i>		90			95

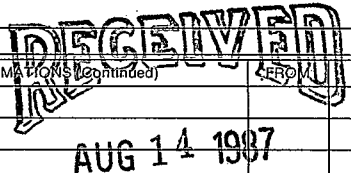

Department of Natural Resources
Bureau of Land & Water Resources

IF MORE SPACE IS NEEDED, USE BACK

If well telescopes please sketch and show depths.

GROUND LEVEL

		X	

SECTION 23

Please indicate well location X.

ADDITIONAL INFORMATION

If more than one screen,
show location of each on sketch.