

**MISSISSIPPI DEPARTMENT OF NATURAL RESOURCES**  
Bureau of Land and Water Resources

P.O. Box 10631

Jackson, Mississippi 39209

**WATER WELL DRILLERS LOG**

COUNTY WELL LOCATED <i>Lincoln</i>
WELL NUMBER <i>P 2071</i>
CODED
DATE WELL COMPLETED <i>June 14 88</i>

PERMIT NUMBER
NAME OF DRILLING FIRM <i>FITZGERALD Well Serv</i>

NAME & MAILING ADDRESS OF LANDOWNER <i>Ray Reeves</i> <i>R.R. Boye c/o Mr.</i>
WELL LOCATION: SEC <u>22</u> TOWNSHIP <u>5</u> RANGE <u>7</u> <i>N S E W</i>
DISTANCE <u>8</u> Miles <u>SW</u> of <u>Boye c/o</u>
OTHER LANDMARK
WELL PURPOSE: Home, Irrigation, Municipal, Industrial, Fish Pond, etc. <i>Home</i>

<b>PUMP DATA</b>		
PUMP TYPE (Circle One): <u>Submersible</u> Turbine, Jet, Flowing Well, Other (Describe) _____		
POWER TYPE (Circle One): <u>Electric</u> Tractor, Diesel, Gasoline, Butane, Other (Describe) _____		
Pump Capacity (GPM) <i>10</i>	No. of Stages <i>10</i>	Setting Depth <i>80</i> FT.
PUMP TEST		
Well yielded <u>10</u> GPM with a drawdown of <u>3</u> ft. after <u>2</u> hours of pumping		

<b>WELL DATA</b>		
Well Depth <i>86</i>	Casing Diameter (In.) <i>4</i>	Casing Length (Ft.) <i>76</i>
Type of Casing <i>PVC</i>	Hole Depth <i>86</i>	Depth to Static Water Level <i>67</i>
TYPE OF COMPLETION: (Circle One or More): <u>Gravel Packed</u> , Underreamed, Telescoped, Natural Development, Open Hole, Other (Describe) _____		
Top of Lap Pipe or Reduction in Casing <b>FEET</b> IF TELESCOPED OR MORE THAN ONE SCREEN: USE BACK PAGE		

<b>LOG DATA</b>	
TYPE OF LOG RUN (Circle One): <u>No Log Run</u> , Electric, Gamma Ray, Density, Sonic, Neutron, Other (Describe) _____	
Name of Organization Running Log	

<b>SCREEN DATA</b>		
Diameter - Inches <i>4</i>	Length - Feet <i>10</i>	Slot Size - Inches <i>1014</i>
Screen Type <i>PVC</i>	Depth to Bottom - Feet <i>86</i>	

<b>GEOLOGIC DATA (Office Use Only)</b>			
Surface Elev.	Geologic Unit	Unit Thickness	Depth to Top
Subs. SWL	Date	Analysis	Aquifer Test


Driller's Remarks
DECEIVED

DESCRIPTION OF FORMATIONS ENCOUNTERED	FROM	TO	FORMATIONS (Continued)	FROM	TO
<i>Red clay</i>	<i>0</i>	<i>20</i>	<b>AUG 03 1988</b>  Department of Natural Resources Bureau of Land & Water Resources		
<i>Red sand</i>	<i>20</i>	<i>72</i>			
<i>Coarse sand &amp; gravel</i>	<i>72</i>	<i>86</i>			

IF MORE SPACE IS NEEDED, USE BACK

If well telescopes please  
sketch and show depths.

GROUND LEVEL

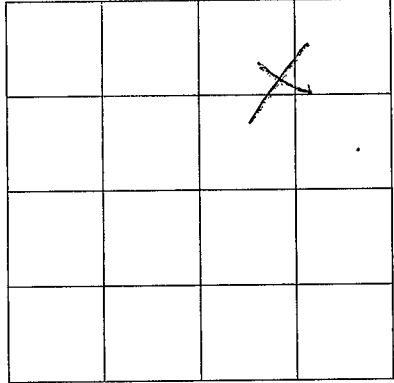

SECTION 22

Please indicate well location X.

ADDITIONAL INFORMATION

If more than one screen,  
show location of each on sketch.