

MISSISSIPPI DEPARTMENT OF NATURAL RESOURCES

Bureau of Land and Water Resources

Southport Mall

P.O. Box 10631

Jackson, Mississippi 39209

WATER WELL DRILLERS LOG

Lincoln  
P 2074


Nov 13 1989 date well completed  
J. J. Goolsby Well Serv firm name  
Lincoln county well located

LANDOWNER:	description of formations encountered	from	to
J. B. Brock			
Rd. - Boyce City, Miss. (mailing address)	Reel Sand	20	85
	Coarse Sandstone	85	106

WELL LOCATION:  
sec. 34 T-5 N R-7 E  
S W  
5 miles H of Summit  
(distance) (direction) (nearest town)

WELL PURPOSE: Home  
(home, irrigation, municipal, industrial)

- WELL COMPLETION DATA:
- (1) diameter (inches) 4
  - (2) total depth (feet) 106
  - (3) static water level (feet) 37 below top of ground.
  - (4) casing PVC, 96 (material), (depth)  
4 (size) if telescope see back.
  - (5) screen 10, 96 (length), (depth to top)  
4 (size), PVC (material)
  - (6) pump 1/2, 10 (HP), (yield gpm)  
elec (type power)
  - (7) electric log No (yes or no)  
(organization running log)
  - (8) how well bottom plugged Seal Hole

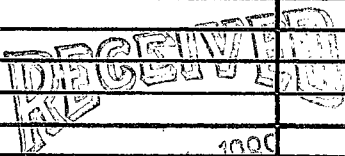


DEC 11 1989

Department of Natural Resources  
Bureau of Land & Water Resources

DRILLERS REMARKS:

If well telescopes please sketch and show depths.

GROUND LEVEL

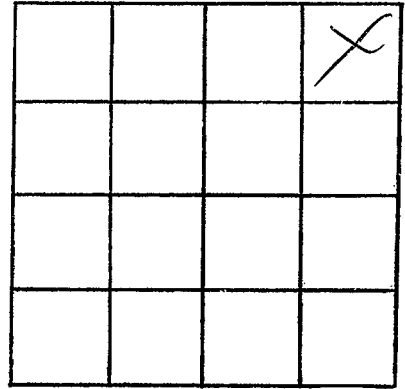

SECTION 34

Please indicate well location X.

ADDITIONAL INFORMATION

If more than one screen,  
show locations of each on sketch.