

# MISSISSIPPI DEPARTMENT OF NATURAL RESOURCES

Bureau of Land and Water Resources

P.O. Box 10631

Jackson, Mississippi 39209

## WATER WELL DRILLERS LOG

COUNTY WELL LOCATED <i>Lincoln</i>	
WELL NUMBER <i>P 2876</i>	CODED
DATE WELL COMPLETED <i>10/27/88</i>	

PERMIT NUMBER
NAME OF DRILLING FIRM <i>Eassey Water Well</i>
<i>Brookhaven, MS 39601</i>

NAME & MAILING ADDRESS OF LANDOWNER <i>Melvin Albritton</i>			
<i>Brookhaven, MS</i>			
<i>39601</i>			
WELL LOCATION:	SEC	TOWNSHIP	RANGE
<i>Lincoln</i>	<i>4</i>	<i>5</i>	<i>N 7 E</i>
DISTANCE	DIRECTION	NEAREST TOWN	
<i>5</i> Miles	<i>N</i>	of <i>Summitt</i>	
OTHER LANDMARK <i>3 miles from Greensboro</i>			
WELL PURPOSE: Home Irrigation, Municipal, Industrial, Fish Pond, etc. <i>Home</i>			

PUMP DATA		
PUMP TYPE (Circle One): Submersible, Turbine, Jet, Flowing Well, Other (Describe) <i>NO PUMP</i>		
POWER TYPE (Circle One): Electric, Tractor, Diesel, Gasoline, Butane, Other (Describe) <i>H/P</i>		
Pump Capacity (GPM)	No. of Stages	Setting Depth  FT.
PUMP TEST		
Well yielded _____ GPM with a drawdown of _____ ft. after _____ hours of pumping		

WELL DATA		
Well Depth <i>110 ft.</i>	Casing Diameter (In.) <i>4 in.</i>	Casing Length (Ft.) <i>90 ft.</i>
Type of Casing <i>W/C</i>	Hole Depth <i>110 ft.</i>	Depth to Static Water Level
TYPE OF COMPLETION: (Circle One or More): Gravel Packed, Underreamed, Telescoped, <u>Natural Development</u> , Open Hole, Other		
Top of Lap Pipe or Reduction in Casing  FEET <input type="checkbox"/> IF TELESCOPED OR MORE THAN ONE SCREEN: USE BACK PAGE		

LOG DATA	
TYPE OF LOG RUN (Circle One): Electric, Gamma Ray, Density, Sonic, Neutron, Other (Describe) _____ No Log Run	
Name of Organization Running Log	

SCREEN DATA		
Diameter - Inches <i>4 in.</i>	Length - Feet <i>20 ft.</i>	Slot Size - Inches <i>0.10</i>
Screen Type <i>W/C</i>	Depth to Bottom - Feet <i>110 ft.</i>	


GEOLOGIC DATA (Office Use Only)			
Surface Elev.	Geologic Unit	Unit Thickness	Depth to Top
Subs. SWL <sup>1</sup>	Date	Analysis	Aquifer Test
Driller's Remarks			

DESCRIPTION OF FORMATIONS ENCOUNTERED	FROM	TO
<i>Day</i>	<i>0 ft.</i>	<i>20 ft.</i>
<i>Gravel</i>	<i>20 ft.</i>	<i>40 ft.</i>
<i>Clay</i>	<i>40 ft.</i>	<i>60 ft.</i>
<i>Yellow Gravel</i>	<i>60 ft.</i>	<i>110 ft.</i>

FORMATIONS (Continued)		FROM	TO
<b>RECEIVED</b>			
<b>APR 16 1990</b>			
Department of Natural Resources Bureau of Land & Water Resources			
IF MORE SPACE IS NEEDED, USE BACK			

If well telescopes please sketch and show depths.

GROUND LEVEL

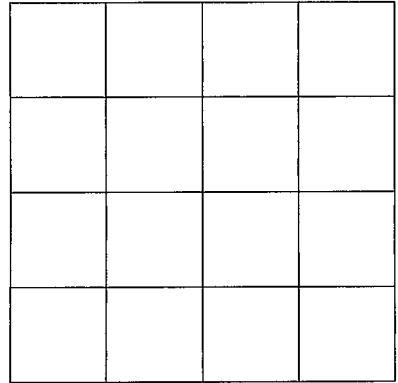

SECTION \_\_\_\_\_

Please indicate well location X.

ADDITIONAL INFORMATION

If more than one screen,  
show location of each on sketch.