

**MISSISSIPPI DEPARTMENT OF ENVIRONMENTAL QUALITY**  
Bureau of Land and Water Resources

P. O. Box 10631  
Jackson, MS 39289-0631  
**WATER WELL DRILLERS LOG**

COUNTY WELL LOCATED <i>Lincoln</i>	
WELL NUMBER <i>P 2081</i>	CODED
DATE WELL COMPLETED <i>Feb 8 91</i>	

PERMIT NUMBER
NAME OF DRILLING FIRM <i>F. FERGUSON Well Serv</i>

NAME & MAILING ADDRESS OF LANDOWNER <i>Hugh Robinson</i> <i>RR. Bayou Bluffs ms.</i>			
WELL LOCATION:	SEC	TOWNSHIP	RANGE
	<i>15</i>	<i>5<sup>N</sup></i>	<i>7<sup>W</sup></i>
DISTANCE	DIRECTION	NEAREST TOWN	
<i>4</i> Miles	<i>SSE</i>	<i>ARL. Hg. town</i>	
OTHER LANDMARK			
WELL PURPOSE: Home, Irrigation, Municipal, Industrial, Fish Pond, etc. <i>Home</i>			

PUMP DATA		
PUMP TYPE (Circle One): <input checked="" type="checkbox"/> Submersible, Turbine, Jet, Flowing Well, Other (Describe) _____		
POWER TYPE (Circle One): <input checked="" type="checkbox"/> Electric, Tractor, Diesel, Gasoline, Butane, Other (Describe) _____ H/P _____		
Pump Capacity (GPM) <i>10</i>	No. of Stages <i>9</i>	Setting Depth <i>70</i> FT.
PUMP TEST		
Well yielded <i>15</i> GPM with a drawdown of <i>1</i> ft. after <i>2</i> hours of pumping		


WELL DATA		
Well Depth <i>92</i>	Casing Diameter (In.) <i>4</i>	Casing Length (Ft.) <i>82</i>
Type of Casing <i>PVC</i>	Hole Depth <i>92</i>	Depth to Static Water Level <i>45</i>
TYPE OF COMPLETION: (Circle One or More): <input checked="" type="checkbox"/> Gravel Packed, Underreamed, Telescoped, Natural Development, Open Hole, Other (Describe) _____		
Top of Lap Pipe or Reduction in Casing		
FEET		
IF TELESCOPED OR MORE THAN ONE SCREEN: USE BACK PAGE		

LOG DATA	
TYPE OF LOG RUN (Circle One): Electric, Gamma Ray, Density, Sonic, Neutron, Other (Describe) _____	
<input checked="" type="checkbox"/> No Log Run	
Name of Organization Running Log	

SCREEN DATA		
Diameter - Inches <i>4</i>	Length - Feet <i>10</i>	Slot Size - Inches <i>.014</i>
Screen Type <i>PVC</i>	Depth to Bottom - Feet <i>82</i>	

GEOLOGIC DATA (Office Use Only)			
Surface Elev.	Geologic Unit	Unit Thickness	Depth to Top
Subs. SWL	Date	Analysis	Aquifer Test
Driller's Remarks			


DESCRIPTION OF FORMATIONS ENCOUNTERED	FROM	TO
<i>Red Clay</i>	<i>0</i>	<i>20</i>
<i>Red Sand</i>	<i>20</i>	<i>73</i>
<i>Coarse Sand &amp; gravel</i>	<i>73</i>	<i>92</i>

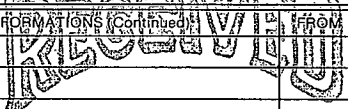FORMATIONS (Continued)	FROM	TO
 <b>APR 01 1991</b> Dept. of Environmental Quality Bureau of Land & Water Resources		

IF MORE SPACE IS NEEDED, USE BACK

If well telescopes please  
sketch and show depths.

GROUND LEVEL

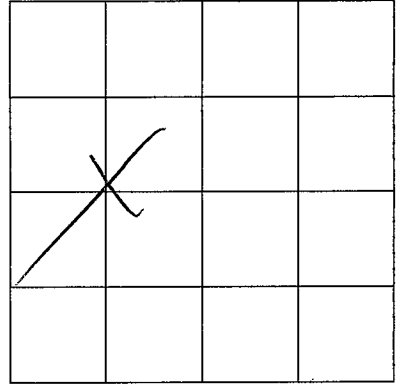

SECTION 15

Please indicate well location X.

ADDITIONAL INFORMATION

If more than one screen,  
show location of each on sketch.