

MISSISSIPPI DEPARTMENT OF ENVIRONMENTAL QUALITY

Office of Land and Water Resources

P. O. Box 10631
Jackson, MS 39289-0631
WATER WELL DRILLERS LOG

COUNTY WELL LOCATED <u>Licon</u>	
WELL NUMBER <u>P 2097</u>	CODE#
DATE WELL COMPLETED <u>2-9-93</u>	

PERMIT NUMBER
NAME OF DRILLING FIRM <u>Fitzerald Water Well</u>

NAME & MAILING ADDRESS OF LANDOWNER <u>Haddie Pendergraft</u> <u>RR Bogue chitto</u>			
WELL LOCATION:	SEC <u>32</u>	TOWNSHIP <u>S</u>	RANGE <u>7</u> N S E W
DISTANCE <u>5</u> Miles	DIRECTION <u>South</u>	NEAREST TOWN <u>Bogue chitto</u>	
OTHER LANDMARK			
WELL PURPOSE <input checked="" type="radio"/> Home, <input type="radio"/> Irrigation, <input type="radio"/> Municipal, <input type="radio"/> Industrial, <input type="radio"/> Fish Pond, etc.			

PUMP DATA		
PUMP TYPE (Circle One): <input checked="" type="radio"/> Submersible, <input type="radio"/> Turbine, <input type="radio"/> Jet <input type="radio"/> Flowing Well, Other (Describe) _____		
POWER TYPE (Circle One): Electric, <input type="radio"/> Tractor, <input type="radio"/> Diesel, <input type="radio"/> Gasoline, <input type="radio"/> Butane, Other (Describe) _____ H/P <u>1/2</u>		
Pump Capacity (GPM) <u>10</u>	No. of Stages <u>8</u>	Setting Depth <u>90'</u> FT.
PUMP TEST		
Well yielded <u>50</u> GPM with a drawdown of <u>3</u> ft. after <u>2</u> hours of pumping		

WELL DATA		
Well Depth <u>100'</u>	Casing Diameter (In.) <u>4"</u>	Casing Length (Ft.) <u>90'</u>
Type of Casing <u>PVC</u>	Hole Depth <u>100'</u>	Depth to Static Water Level <u>53'</u>

LOG DATA	
TYPE OF LOG RUN (Circle One): Electric, <input type="radio"/> Gamma Ray, <input type="radio"/> Density, <input type="radio"/> Sonic, <input type="radio"/> Neutron, Other (Describe) _____	
Name of Organization Running Log	

TYPE OF COMPLETION: (Circle One or More):
 Gravel Packed, Underreamed, Telescoped,
 Natural Development, Open Hole, Other
 (Describe) _____

WELL GROUTED TO A DEPTH OF 0-10 FEET
 Type Grout (circle one): Cement, Bentonite, or Mix

GEOLOGIC DATA (Office Use Only)			
Surface Elev.	Geologic Unit	Unit Thickness	Depth to Top
Subs. SWL	Date	Analysis	Aquifer Test
Driller's Remarks			


SCREEN DATA		
Diameter - Inches <u>4"</u>	Length - Feet <u>10'</u>	Slot Size - Inches <u>.014</u>
Screen Type <u>PVC Gsch 40</u>	Depth to Bottom - Feet <u>100'</u>	

DESCRIPTION OF FORMATIONS ENCOUNTERED	FROM	TO
<u>Red clay</u>	<u>0</u>	<u>20</u>
<u>Red sand</u>	<u>20</u>	<u>40</u>
<u>Red clay</u>	<u>40</u>	<u>50</u>
<u>Red sand</u>	<u>50</u>	<u>90</u>
<u>Coarse Sand & gravel</u>	<u>90</u>	<u>100</u>

FORMATIONS (Continued)	FROM	TO
RECEIVED		
MAR 31 1993		
Dept. of Environmental Quality Office of Land & Water Resources		
IF MORE SPACE IS NEEDED, USE BACK		

If well telescopes please sketch and show depths.

GROUND LEVEL

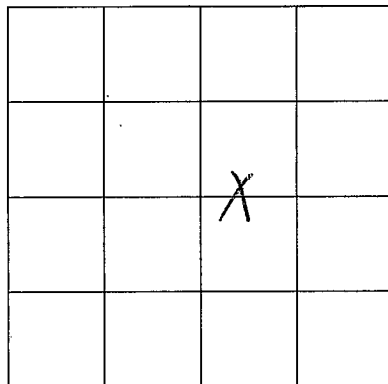

SECTION _____
Please indicate well location X.

ADDITIONAL INFORMATION

If more than one screen,
show location of each on sketch.