

MISSISSIPPI DEPARTMENT OF ENVIRONMENTAL QUALITY

Office of Land and Water Resources

P. O. Box 10631
Jackson, MS 39289-0631

WATER WELL DRILLERS LOG

COUNTY WELL LOCATED <u>Lincoln</u>	
WELL NUMBER <u>P 2098</u>	CODED
DATE WELL COMPLETED <u>10-24-94</u>	

PERMIT NUMBER
NAME OF DRILLING FIRM <u>Green Water Well & Supply</u>

NAME & MAILING ADDRESS OF LANDOWNER <u>Charles Nettles</u>		
<u>1010 Boque Chitto Rd. S.W.</u>		
<u>Boque Chitto MS 39629</u>		
WELL LOCATION: SEC	TOWNSHIP	RANGE
<u>6</u>	<u>5</u> ^N	<u>7</u> ^W
DISTANCE	DIRECTION	NEAREST TOWN
<u>5</u> Miles	<u>West</u>	of <u>Boque Chitto</u>
OTHER LANDMARK		
WELL PURPOSE (<u>Home</u>) Irrigation, Municipal, Industrial, Fish Pond, etc.		

PUMP DATA		
PUMP TYPE (Circle One): Submersible, Turbine, Jet, Flowing Well, Other (Describe) _____		
POWER TYPE (Circle One): Electric, Tractor, Diesel, Gasoline, Butane, Other (Describe) _____		
Pump Capacity (GPM)	No. of Stages	Setting Depth _____ FT.
PUMP TEST		
Well yielded _____ GPM with		
a drawdown of _____ ft.		
after _____ hours of pumping		

WELL DATA		
Well Depth <u>90 ft.</u>	Casing Diameter (In.) <u>4 in.</u>	Casing Length (Ft.) <u>80 ft.</u>
Type of Casing <u>PVC</u>	Hole Depth <u>100 ft.</u>	Depth to Static Water Level <u>42</u>
TYPE OF COMPLETION: (Circle One or More): <u>Gravel Packed</u> , Underreamed, Telescoped, Natural Development, Open Hole, Other (Describe) _____		

LOG DATA	
TYPE OF LOG RUN (Circle One): <u>No Log Run</u> Electric, Gamma Ray, Density, Sonic, Neutron, Other (Describe) _____	
Name of Organization Running Log	

WELL GROUTED TO A DEPTH OF <u>10</u> FEET
Type Grout (circle one): Cement, Bentonite, or <u>Mix</u>

GEOLOGIC DATA (Office Use Only)			
Surface Elev.	Geologic Unit	Unit Thickness	Depth to Top
Subs. SWL	Date	Analysis	Aquifer Test

SCREEN DATA		
Diameter - Inches <u>4 in.</u>	Length - Feet <u>10 ft.</u>	Slot Size - Inches <u>.010</u>
Screen Type <u>PVC</u>	Depth to Bottom - Feet <u>90 ft.</u>	

Driller's Remarks
Top of Lap Pipe or Reduction in Casing
FEET
IF TELESCOPED OR MORE THAN ONE SCREEN: USE BACK PAGE


DESCRIPTION OF FORMATIONS ENCOUNTERED	FROM	TO
<u>Red Clay</u>	<u>0</u>	<u>12</u>
<u>Sand & Gravel</u>	<u>12</u>	<u>38</u>
<u>Fine Sand</u>	<u>38</u>	<u>48</u>
<u>Coarse Sand</u>	<u>48</u>	<u>93</u>
<u>White Clay</u>	<u>93</u>	<u>100</u>

FORMATIONS (Continued)	FROM	TO
RECEIVED		
MAR 15 1995		
Dept. of Environmental Quality Office of Land & Water Resources		

IF MORE SPACE IS NEEDED, USE BACK

If well telescopes please sketch and show depths.

GROUND LEVEL

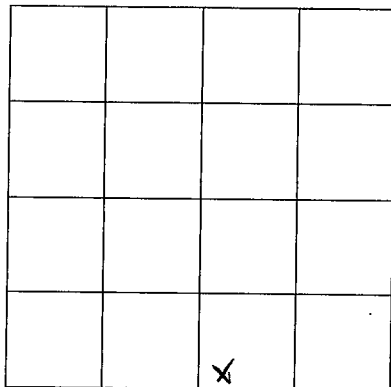

SECTION 6

Please indicate well location X.

ADDITIONAL INFORMATION

If more than one screen,
show location of each on sketch.