

MISSISSIPPI DEPARTMENT OF ENVIRONMENTAL QUALITY

Office of Land and Water Resources

P. O. Box 10631
Jackson, MS 39289-0631
WATER WELL DRILLERS LOG

COUNTY, WELL LOCATED Franklin Lincoln	
WELL NUMBER D 2108	CODED
DATE WELL COMPLETED 7-27-96	

PERMIT NUMBER
NAME OF DRILLING FIRM Fitzgerald Well Service

NAME & MAILING ADDRESS OF LANDOWNER Clinton Dunn RR Summit			
WELL LOCATION:	SEC 33	TOWNSHIP 5	RANGE 7 <small>E W</small>
DISTANCE 4 Miles	DIRECTION NW	NEAREST TOWN Summit	
OTHER LANDMARK			
WELL PURPOSE: <input checked="" type="radio"/> Home Irrigation, <input type="radio"/> Municipal, <input type="radio"/> Industrial, <input type="radio"/> Fish Pond, etc.			

PUMP DATA			
PUMP TYPE (Circle One): <input checked="" type="radio"/> Submersible, <input type="radio"/> Turbine, <input type="radio"/> Jet <input type="radio"/> Flowing Well, Other (Describe) _____			
POWER TYPE (Circle One): <input checked="" type="radio"/> Electric, <input type="radio"/> Tractor, <input type="radio"/> Diesel, <input type="radio"/> Gasoline <input type="radio"/> Butane, Other (Describe) _____ H/P 12			
Pump Capacity (GPM) 10'	No. of Stages 8	Setting Depth 84	FT.
PUMP TEST			
Well yielded 50 GPM with a drawdown of 1 ft. after 1 hours of pumping			

WELL DATA		
Well Depth 107	Casing Diameter (In.) 4"	Casing Length (Ft.) 97'
Type of Casing PVC	Hole Depth 107'	Depth to Static Water Level 52'
TYPE OF COMPLETION: (Circle One or More): <input checked="" type="radio"/> Gravel Packed, <input type="radio"/> Underreamed, <input type="radio"/> Telescoped, <input type="radio"/> Natural Development, <input type="radio"/> Open Hole, <input type="radio"/> Other (Describe) _____		
WELL GROUTED TO A DEPTH OF 10 FEET Type Grout (circle one): Cement, Bentonite, or Mix <input checked="" type="radio"/>		

LOG DATA	
TYPE OF LOG RUN (Circle One): <input type="radio"/> Electric, <input type="radio"/> Gamma Ray, <input type="radio"/> Density, <input type="radio"/> Sonic, <input checked="" type="radio"/> Neutron, Other (Describe) _____	
Name of Organization Running Log	

SCREEN DATA		
Diameter - Inches 4"	Length - Feet 10	Slot Size - Inches .012
Screen Type PVC	Depth to Bottom - Feet 107'	

GEOLOGIC DATA (Office Use Only)			
Surface Elev.	Geologic Unit	Unit Thickness	Depth to Top
Subs. SWL	Date	Analysis	Aquifer Test
Driller's Remarks			
Top of Lap Pipe or Reduction in Casing			

DESCRIPTION OF FORMATIONS ENCOUNTERED	FROM	TO
Top Soil	0	5
red clay	5	30
Sand & gravel	30	80
Fine sand	80	97'
coarse sand	97	107

IF TELESCOPED OR MORE THAN
FEET, ONE SCREEN, USE BACK PAGE

RECEIVED


DEC 02 1996

Dept. of Environmental Quality
Office of Land & Water Resources

IF MORE SPACE IS NEEDED, USE BACK

If well telescopes please
sketch and show depths.

GROUND LEVEL

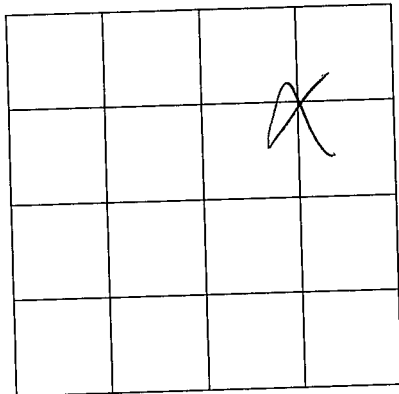

SECTION _____

Please indicate well location X.

ADDITIONAL INFORMATION

Lined area for additional information.

If more than one screen,
show location of each on sketch.