

**MISSISSIPPI DEPARTMENT OF ENVIRONMENTAL QUALITY**

Office of Land and Water Resources

P. O. Box 10631  
Jackson, MS 39289-0631

**WATER WELL DRILLERS LOG**

COUNTY WELL LOCATED <i>Madison</i>	
WELL NUMBER <i>2119</i>	CODED
DATE WELL COMPLETED <i>7-30-98</i>	

PERFORMED BY <b>Green Water Well &amp; Supply</b>
ADDRESS <b>1318 Pricedale Dr. SE</b>
NAME OF DRILLING FIRM <b>Bogue Chitto</b>
CITY/STATE/ZIP <b>Chitto, MS 39629</b>

NAME & MAILING ADDRESS OF LANDOWNER <i>Lot #2</i> <i>Gordon Wallace</i>			
<i>3109 Wallace Dr. SW</i>			
<i>Bogue Chitto</i>			
WELL LOCATION:	SEC	TOWNSHIP	RANGE
	<i>21</i>	<i>5</i>	<i>N 7 E</i>
DISTANCE	DIRECTION	NEAREST TOWN	
<i>2</i> Miles	<i>SW</i>	of <i>Norfield</i>	
OTHER LANDMARK			
WELL PURPOSE: <input checked="" type="checkbox"/> Home; Irrigation, Municipal, Industrial, Fish Pond, etc.			

<b>PUMP DATA</b>		
PUMP TYPE (Circle One): Submersible, Turbine, Jet, Flowing Well, Other (Describe) _____		
POWER TYPE (Circle One): Electric, Tractor, Diesel, Gasoline, Butane, Other (Describe) _____ H/P _____		
Pump Capacity (GPM)	No. of Stages	Setting Depth _____ FT.
PUMP TEST		
Well yielded _____ GPM with a drawdown of _____ ft. after _____ hours of pumping		

<b>WELL DATA</b>		
Well Depth <i>90'</i>	Casing Diameter (In.) <i>4"</i>	Casing Length (Ft.) <i>80'</i>
Type of Casing <i>PVC</i>	Hole Depth <i>100'</i>	Depth to Static Water Level <i>15'</i>

<b>LOG DATA</b>	
TYPE OF LOG RUN (Circle One): No Log Run, Electric, Gamma Ray, Density, Sonic, Neutron, Other (Describe) _____	
Name of Organization Running Log	

TYPE OF COMPLETION: (Circle One or More):  
 Gravel Packed     Underreamed,     Telescoped,  
 Natural Development,     Open Hole,     Other  
 (Describe) \_\_\_\_\_

WELL GROUTED TO A DEPTH OF 10 FEET  
 Type Grout (circle one): Cement, Bentonite, or  Mix

<b>GEOLOGIC DATA (Office Use Only)</b>			
Surface Elev.	Geologic Unit	Unit Thickness	Depth to Top
Subs. SWL	Date	Analysis	Aquifer Test
Driller's Remarks			
Top of Lap Pipe or Reduction in Casing			
FEET		IF TELESCOPED OR MORE THAN ONE SCREEN: USE BACK PAGE	

<b>SCREEN DATA</b>		
Diameter - Inches <i>4"</i>	Length - Feet <i>10'</i>	Slot Size - Inches <i>.010</i>
Screen Type <i>PVC</i>	Depth to Bottom - Feet	

DESCRIPTION OF FORMATIONS ENCOUNTERED	FROM	TO	FORMATIONS (Continued)	
			FROM	TO
<i>Red Clay</i>	<i>0</i>	<i>10</i>		
<i>Sand/Gravel</i>	<i>10</i>	<i>93</i>		
<i>Yellow Clay</i>	<i>93</i>	<i>100</i>		

**RECEIVED**

**JAN 25 1999**

**Dept. of Environmental Quality  
Office of Land & Water Resources**

IF MORE SPACE IS NEEDED, USE BACK

If well telescopes please sketch and show depths.


GROUND LEVEL

		X	

SECTION 21

Please indicate well location X.

ADDITIONAL INFORMATION

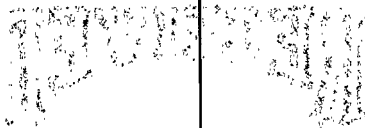

*[Faint, illegible text]*

If more than one screen,  
show location of each on sketch.