

**MISSISSIPPI DEPARTMENT OF ENVIRONMENTAL QUALITY**

Office of Land and Water Resources

P. O. Box 10631  
Jackson, MS 39289-0631  
**WATER WELL DRILLERS LOG**

COUNTY WELL LOCATED <i>Lincoln</i>	
WELL NUMBER <i>P 2122</i>	CODED
DATE WELL COMPLETED <i>12-7-98</i>	

PERMIT NO. <b>Green Water Well &amp; Supply</b>
1318 Pricedale Dr. SE
NAME OF DRILLING FIRM <b>Bogue Chitto, MS 39629</b>

NAME & MAILING ADDRESS OF LANDOWNER <i>Brenda Stevenson</i>			
<i>678 Bogue Chitto Rd</i>			
<i>Bogue Chitto</i>			
WELL LOCATION:	SEC	TOWNSHIP	RANGE
	<i>5</i>	<i>5</i>	<i>7</i>
		<i>S</i>	<i>W</i>
DISTANCE	DIRECTION	NEAREST TOWN	
<i>4</i>	<i>W</i>	<i>Bogue Chitto</i>	
OTHER LANDMARK			
WELL PURPOSE (Home) <input checked="" type="checkbox"/> Irrigation, Municipal, Industrial, Fish Pond, etc.			

<b>PUMP DATA</b>		
PUMP TYPE (Circle One): Submersible, Turbine, Jet, Flowing Well, Other (Describe) _____		
POWER TYPE (Circle One): Electric, Tractor, Diesel, Gasoline, Butane, Other (Describe) _____ H/P <i>V2</i>		
Pump Capacity (GPM) <i>10</i>	No. of Stages <i>9</i>	Setting Depth <i>48</i> FT.
PUMP TEST		
Well yielded <i>10</i> GPM with a drawdown of <i>0</i> ft. after <i>1</i> hours of pumping		

<b>WELL DATA</b>		
Well Depth <i>50'</i>	Casing Diameter (In.) <i>4"</i>	Casing Length (Ft.) <i>40</i>
Type of Casing <i>PVC</i>	Hole Depth <i>60</i>	Depth to Static Water Level <i>18'</i>

<b>LOG DATA</b>	
TYPE OF LOG RUN (Circle One): Electric, Gamma Ray, Density, Sonic, Neutron, Other (Describe) _____	
<i>No Log Run</i>	
Name of Organization Running Log	

TYPE OF COMPLETION: (Circle One or More): <input checked="" type="checkbox"/> Gravel Packed, <input type="checkbox"/> Underreamed, <input type="checkbox"/> Telescoped, <input type="checkbox"/> Natural Development, <input type="checkbox"/> Open Hole, <input type="checkbox"/> Other			
WELL GROUTED TO A DEPTH OF <i>10</i> FEET			
Type Grout (circle one): Cement, Bentonite, or <i>Mix</i>			

<b>GEOLOGIC DATA (Office Use Only)</b>			
Surface Elev.	Geologic Unit	Unit Thickness	Depth to Top
Subs. SWL	Date	Analysis	Aquifer Test
Driller's Remarks			
Top of Lap Pipe or Reduction in Casing			
FEET		IF TELESCOPED OR MORE THAN ONE SCREEN: USE BACK PAGE	

<b>SCREEN DATA</b>		
Diameter - Inches <i>4"</i>	Length - Feet <i>10'</i>	Slot Size - Inches <i>.010</i>
Screen Type <i>PVC</i>	Depth to Bottom - Feet <i>50'</i>	

DESCRIPTION OF FORMATIONS ENCOUNTERED	FROM	TO
<i>Red Clay</i>	<i>0</i>	<i>19</i>
<i>Sand/Gravel</i>	<i>19</i>	<i>52</i>
<i>White Clay</i>	<i>52</i>	<i>60</i>

FORMATIONS (Continued)	FROM	TO
<b>RECEIVED</b>		
<b>JAN 25 1999</b>		
Dept. of Environmental Quality Office of Land & Water Resources		
IF MORE SPACE IS NEEDED, USE BACK		

If well telescopes please  
sketch and show depths.


GROUND LEVEL

		X	

SECTION 5

Please indicate well location X.

ADDITIONAL INFORMATION

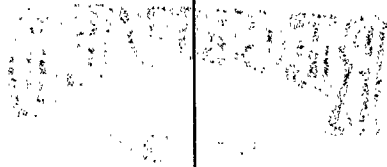

If more than one screen,  
show location of each on sketch.