

5/12/00

MISSISSIPPI DEPARTMENT OF ENVIRONMENTAL QUALITY

Office of Land and Water Resources

P. O. Box 10631
Jackson, MS 39289-0631
WATER WELL DRILLERS LOG

COUNTY WELL LOCATED
Leflore

WELL NUMBER
P-2434

CODED

DATE WELL COMPLETED
5-17-00

Ground Water Well & Supply
1318 Pricedale Dr. SE
Bogue Chitto, MS 39629

NAME & MAILING ADDRESS OF LANDOWNER
Jimmy Moak
2842 Big Creek Dr. SW
Bogue Chitto

WELL LOCATION: SEC 15 TOWNSHIP 5 RANGE 7

DISTANCE 2 Miles DIRECTION SE of Bogue Chitto

OTHER LANDMARK

WELL PURPOSE: Home, Irrigation, Municipal, Industrial, Fish Pond, etc.

PUMP DATA

PUMP TYPE (Circle One):
 Submersible, Turbine, Jet, Flowing Well,
Other (Describe)

POWER TYPE (Circle One):
 Electric, Tractor, Diesel, Gasoline, Butane,
Other (Describe) H/P 1/2

Pump Capacity (GPM) 10 No. of Stages 9 Setting Depth 68 FT.

PUMP TEST

Well yielded 11 GPM with
a drawdown of 0 ft.
after 1 hours of pumping

WELL DATA

Well Depth 70' Casing Diameter (In.) 4" Casing Length (Ft.) 60'

Type of Casing PVC Hole Depth 84' Depth to Static Water Level 38'

TYPE OF COMPLETION: (Circle One or More):
 Gravel Packed, Underreamed, Telescoped,
Natural Development, Open Hole, Other

WELL GROUTED TO A DEPTH OF 10 FEET
Type Grout (circle one): Cement, Bentonite, or Mix

SCREEN DATA

Diameter - Inches 4 Length - Feet 10 Slot Size - Inches .010

Screen Type PVC Depth to Bottom - Feet 70'

DESCRIPTION OF FORMATIONS ENCOUNTERED	FROM	TO
Red Clay	0	7
Sand & Gravel	7	75
White Clay	75	84

LOG DATA

TYPE OF LOG RUN (Circle One):
Electric, Gamma Ray, Density, Sonic, No Log Run, Neutron,
Other (Describe)

Name of Organization Running Log

GEOLOGIC DATA (Office Use Only)

Surface Elev.	Geologic Unit	Unit Thickness	Depth to Top
Subs. SWL	Date	Analysis	Aquifer Test

Driller's Remarks

Top of Lap Pipe or Reduction in Casing

IF TELESCOPED OR MORE THAN ONE SCREEN, USE BACK PAGE

NEED TO BE RECORDED IN THE FIELD

IF TELESCOPED OR MORE THAN ONE SCREEN, USE BACK PAGE

JUL 10 2000

Dept. of Environmental Quality
Office of Land & Water Resources

IF MORE SPACE IS NEEDED, USE BACK

If well telescopes please sketch and show depths.


GROUND LEVEL

		X	

SECTION 15

Please indicate well location X.

ADDITIONAL INFORMATION

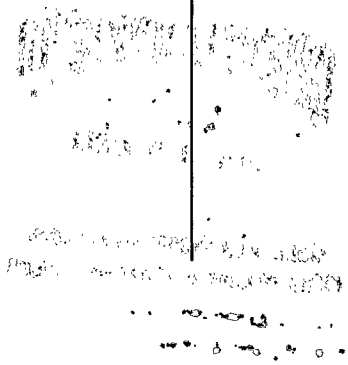

If more than one screen, show location of each on sketch.