

MISSISSIPPI DEPARTMENT OF ENVIRONMENTAL QUALITY
Office of Land and Water Resources

P. O. Box 10631
 Jackson, MS 39289-0631
WATER WELL DRILLERS LOG

| | |
|---------------------------------------|-------|
| COUNTY WELL LOCATED <u>Lincoln</u> | |
| WELL NUMBER <u>P 2143</u> | CODED |
| DATE WELL COMPLETED <u>4/04/01</u> | |

| |
|---|
| PERMIT NUMBER <u>Green Water Well & Supply</u> |
| NAME OF DRILLER <u>1334 Prichard Dr. SE</u> <u>Bogue Chitto, MS 39629</u> |

| | | |
|--|----------------------|-------------------|
| NAME & MAILING ADDRESS OF LANDOWNER <u>Wayne Reeves</u> <u>2897 Shar-pei Ln SW</u> <u>Bogue Chitto MS 39629</u> | | |
| WELL LOCATION: SEC <u>15</u> | TOWNSHIP <u>5</u> | RANGE <u>7</u> |
| DISTANCE DIRECTION NEAREST TOWN <u>2</u> Miles <u>SW</u> of <u>Bogue Chitto</u> | | |
| OTHER LANDMARK | | |
| WELL PURPOSE <input checked="" type="checkbox"/> Home Irrigation, Municipal, Industrial, Fish Pond, etc. | | |

| | | |
|---|---------------------------|--------------------------------|
| PUMP DATA | | |
| PUMP TYPE (Circle One): <input checked="" type="checkbox"/> Submersible, Turbine, Jet, Flowing Well, Other (Describe) _____ | | |
| POWER TYPE (Circle One): <input checked="" type="checkbox"/> Electric, Tractor, Diesel, Gasoline, Butane, Other (Describe) _____ H/P <u>2</u> | | |
| Pump Capacity (GPM) <u>10</u> | No. of Stages <u>9</u> | Setting Depth <u>95</u> FT. |
| PUMP TEST Well yielded <u>10</u> GPM with a drawdown of <u>5</u> ft. after <u>1</u> hours of pumping | | |

| | | |
|---|------------------------------------|--|
| WELL DATA | | |
| Well Depth <u>120</u> | Casing Diameter (In.) <u>4"</u> | Casing Length (Ft.) <u>110'</u> |
| Type of Casing <u>PVC</u> | Hole Depth <u>130</u> | Depth to Static Water Level <u>70</u> |
| TYPE OF COMPLETION: (Circle One or More): <input checked="" type="checkbox"/> Gravel Packed, Underreamed, Telescoped, Natural Development, Open Hole, Other (Describe) _____ | | |

| | |
|--|--|
| LOG DATA | |
| TYPE OF LOG RUN (Circle One): <input checked="" type="checkbox"/> No Log Run, Electric, Gamma Ray, Density, Sonic, Neutron, Other (Describe) _____ | |
| Name of Organization Running Log | |

| |
|---|
| WELL GROUTED TO A DEPTH OF <u>10</u> FEET Type Grout (circle one): Cement, Bentonite, or <input checked="" type="checkbox"/> Mix |
|---|

| | | | |
|--|---------------|----------------|--------------|
| GEOLOGIC DATA (Office Use Only) | | | |
| Surface Elev. | Geologic Unit | Unit Thickness | Depth to Top |
| Subs. SWL | Date | Analysis | Aquifer Test |

| | | |
|--------------------------------|--------------------------------------|-----------------------------------|
| SCREEN DATA | | |
| Diameter - Inches <u>4"</u> | Length - Feet <u>10'</u> | Slot Size - Inches <u>.010</u> |
| Screen Type <u>PVC</u> | Depth to Bottom - Feet <u>120</u> | |

| |
|--|
| Driller's Remarks |
| Top of Lap Pipe or Reduction in Casing |
| FEET |
| IF TELESCOPED OR MORE THAN ONE SCREEN: USE BACK PAGE |


| DESCRIPTION OF FORMATIONS ENCOUNTERED | FROM | TO |
|---------------------------------------|------------|------------|
| <u>Streaky</u> | <u>0</u> | <u>30</u> |
| <u>Sand & Gravel</u> | <u>30</u> | <u>120</u> |
| <u>White Clay</u> | <u>120</u> | <u>130</u> |
| | | |
| | | |
| FORMATIONS (Continued) | FROM | TO |
|------------------------|------|----|
| | | |
| | | |
REC'D JUN 13 2001

If well telescopes please
sketch and show depths.

GROUND LEVEL

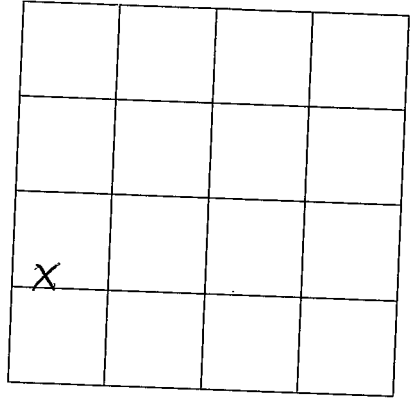

SECTION 15

Please indicate well location X.

ADDITIONAL INFORMATION

If more than one screen,
show location of each on sketch.