

MISSISSIPPI DEPARTMENT OF ENVIRONMENTAL QUALITY

Lincoln
COUNTRY WELL LOCATED
RIFE
WELL NUMBER **P-2145** CODED
DATE WELL COMPLETED
10-13-99

PERMIT NUMBER **0-287**
NAME OF DRILLING FIRM
REEVES WELL SER.

Office of Land and Water Resources

P. O. Box 10631
Jackson, MS 39289-0631
WATER WELL DRILLERS LOG

NAME & MAILING ADDRESS OF LANDOWNER
DATTEL WALLACE JR.
0446 FREEMAN RD. SW
SUMMIT MISS.
WELL LOCATION: SEC **28** TOWNSHIP **5^N** RANGE **7^E**
DISTANCE **5** Miles DIRECTION **NW** of NEAREST TOWN **SUMMIT**
OTHER LANDMARK
WELL PURPOSE: Home, Irrigation, Municipal, Industrial, Fish Pond, etc.

PUMP DATA

PUMP TYPE (Circle One):
Submersible, Turbine, Jet, Flowing Well,
Other (Describe) _____
POWER TYPE (Circle One):
Electric Tractor, Diesel, Gasoline, Butane,
Other (Describe) _____ H/P 1/2
Pump Capacity (GPM) **10** No. of Stages **8** Setting Depth _____ FT.
PUMP TEST
Well yielded **70** GPM with
a drawdown of **0** ft.
after **1** hours of pumping

WELL DATA

Well Depth 138'	Casing Diameter (In.) 4"	Casing Length (Ft.) 20'
Type of Casing PVC	Hole Depth 138	Depth to Static Water Level 80'

TYPE OF COMPLETION: (Circle One or More):
Gravel Packed, Underreamed, Telescoped,
Natural Development, Open Hole, Other
(Describe) **10 GAL. SAND**

WELL GROUTED TO A DEPTH OF **10 FEET**
Type Grout (circle one): Cement, Bentonite, or Mix

LOG DATA

TYPE OF LOG RUN (Circle One): No Log Run,
Electric, Gamma Ray, Density, Sonic, Neutron,
Other (Describe) _____
Name of Organization Running Log

SCREEN DATA

Diameter - Inches 4"	Length - Feet 10'	Slot Size - Inches 10 SLOT
Screen Type PVC	Depth to Bottom - Feet 138'	

GEOLOGIC DATA (Office Use Only)

Surface Elev.	Geologic Unit	Unit Thickness	Depth to Top
Subs. SWL	Date	Analysis	Aquifer Test

Driller's Remarks
REC'D JAN 03 2002


Top of Lap Pipe or Reduction in Casing
FEET IF TELESKOPED OR MORE THAN ONE SCREEN: USE BACK PAGE

DESCRIPTION OF FORMATIONS ENCOUNTERED	FROM	TO	FORMATIONS (Continued)	FROM	TO
CLAY	0	15			
RED SAND	15	30			
SAND & GRAVEL	30	80			
CHALKY SAND & GRAVEL	80	110			
SAND & GRAVEL	110	138			

IF MORE SPACE IS NEEDED, USE BACK

If well telescopes please
sketch and show depths.

GROUND LEVEL

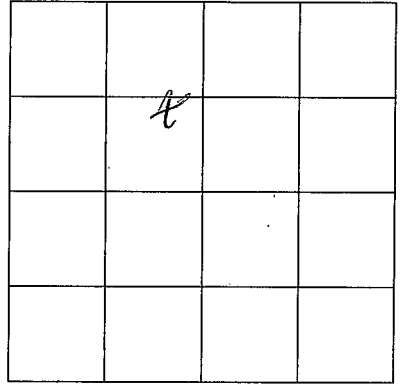

SECTION 28

Please indicate well location X.

ADDITIONAL INFORMATION

If more than one screen,
show location of each on sketch.