

MISSISSIPPI DEPARTMENT OF ENVIRONMENTAL QUALITY

Office of Land and Water Resources

P. O. Box 10631

Jackson, MS 39289-0631

WATER WELL DRILLERS LOG

COUNTY WELL LOCATED <u>Leflore</u>	
WELL NUMBER <u>P-2150</u>	CODED
DATE WELL COMPLETED <u>11/7/01</u>	

PERMIT NUMBER <u>Gretn Water Well & Supply</u>
NAME OF DRILLER <u>DR. SE Bogue Chitto, MS 39629</u>

NAME & MAILING ADDRESS OF LANDOWNER <u>J. R. Roberts / Dana Nettles</u>			
<u>647 Beulah Land Tr., Bogue Chitto</u>			
Latitude: Longitude:			
WELL LOCATION	SEC	TOWNSHIP	RANGE
	<u>5</u>	<u>5</u>	<u>N 7 E</u>
DISTANCE	DIRECTION	NEAREST TOWN	
<u>3</u> Miles	<u>W</u>	of <u>Bogue Chitto</u>	
OTHER LANDMARK			
WELL PURPOSE: <input checked="" type="checkbox"/> Home, <input type="checkbox"/> Irrigation, <input type="checkbox"/> Municipal, <input type="checkbox"/> Industrial, <input type="checkbox"/> Fish Pond, etc.			

PUMP DATA		
PUMP TYPE (Circle One): <input type="checkbox"/> Submersible, <input type="checkbox"/> Turbine, <input type="checkbox"/> Jet, <input type="checkbox"/> Flowing Well, Other (Describe) _____		
POWER TYPE (Circle One): <input checked="" type="checkbox"/> Electric, <input type="checkbox"/> Tractor, <input type="checkbox"/> Diesel, <input type="checkbox"/> Gasoline, <input type="checkbox"/> Butane, Other (Describe) _____ H/P <u>3/4</u>		
DESCRIPTION OF FORMATIONS ENCOUNTERED	FROM	TO
<u>Red Clay</u>	<u>0</u>	<u>12</u>
<u>Sand & Gravel</u>	<u>12</u>	<u>70</u>
<u>White Clay</u>	<u>70</u>	<u>80</u>

WELL DATA		
Well Depth <u>70</u>	Casing Diameter (In.) <u>4</u>	Casing Length (Ft.) <u>60</u>
Type of Casing <u>PVC</u>	Hole Depth <u>80</u>	Depth to Static Water Level <u>29</u>

TYPE OF COMPLETION: (Circle One or More):
 Gravel Packed, Underreamed, Telescoped,
 Natural Development, Open Hole, Other
 (Describe) _____

WELL GROUDED TO A DEPTH OF 10 FEET
 Type Grout (circle one): Cement, Bentonite, or Mix

SCREEN DATA		
Diameter - Inches <u>4</u>	Length - Feet <u>10</u>	Slot Size - Inches <u>.010</u>
Screen Type <u>PVC</u>	Depth to Bottom - Feet <u>70</u>	

RECEIVED
 APR 22 2002
 BY: OLWR

Top of Lap Pipe or Reduction in Casing
 FEET IF TELESCOPED OR MORE THAN ONE SCREEN: USE BACK PAGE


I certify that the well was drilled, constructed and completed in accordance with all applicable Requirements of the Mississippi Department of Environmental Quality and/or the Mississippi Department of Health regulations and state laws.

Brian Mc Cleudon 0-664
 Signature of Licensed Driller and License No.

11/7/01
 Date

If well telescopes please sketch and show depths.

GROUND LEVEL

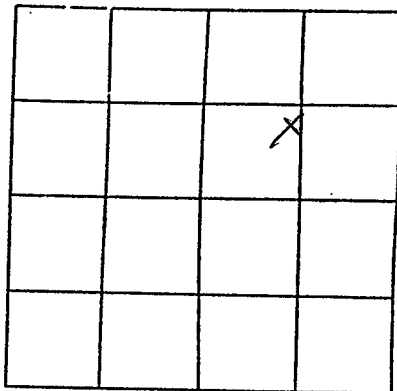

SECTION 5

Please indicate well location X.

Pump Capacity (GPM)	No. of Stages	Setting Depth	
10	12	50	FT.

PUMP TEST

Well yielded 12 GPM with
 a drawdown of 0 ft.
 after 1 hours of pumping

LOG DATA

TYPE OF LOG RUN (Circle One): No Log Run
 Electric, Gamma Ray, Density, Sonic, Neutron,
 Other (Describe) _____

Name of Organization Running Log _____

GEOLOGIC DATA (Office Use Only)

Surface Elev.	Geologic Unit	Unit Thickness	Depth to Top
Subs. SWL	Date	Analysis	Aquifer Test

Driller's Remarks

If more than one screen,
 show location of each on sketch.