


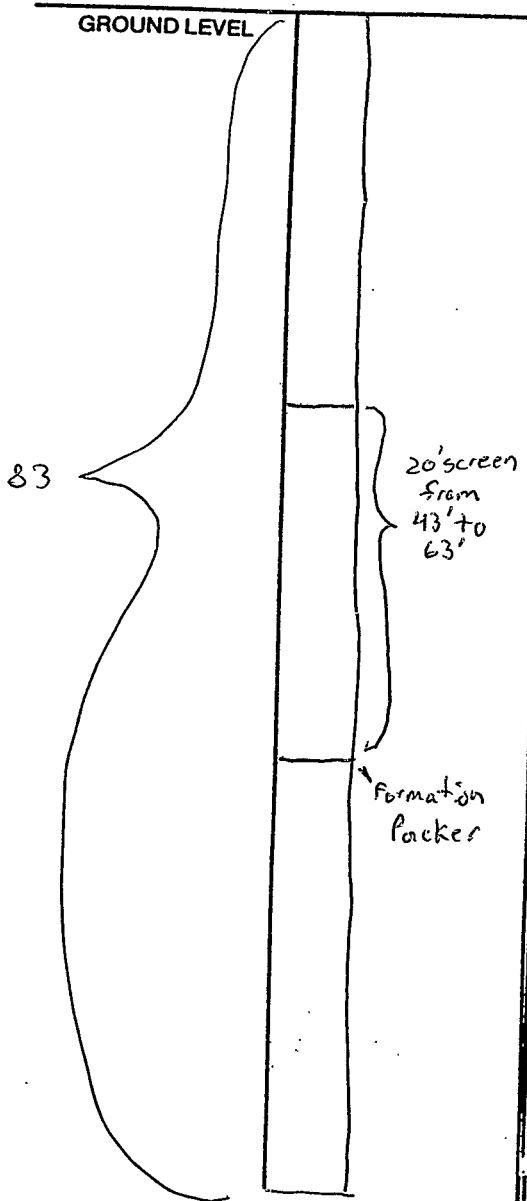

If well telescopes please sketch and show depths.



		X	

SECTION 14

Please indicate well location X.

Pump Capacity (GPM)	No. of Stages	Setting Depth
10	12	65 FT.

PUMP TEST

Well yielded 12 GPM with  
 a drawdown of 0 ft.  
 after 1 hours of pumping

LOG DATA

TYPE OF LOG RUN (Circle One): No Log Run  
 Electric, Gamma Ray, Density, Sonic, Neutron,  
 Other (Describe) \_\_\_\_\_

Name of Organization Running Log \_\_\_\_\_

GEOLOGIC DATA (Office Use Only)

Surface Elev.	Geologic Unit	Unit Thickness	Depth to Top
Subs. SWL	Date	Analysis	Aquifer Test

Driller's Remarks

If more than one screen,  
 show location of each on sketch.