

MISSISSIPPI DEPARTMENT OF ENVIRONMENTAL QUALITY

Office of Land and Water Resources

P. O. Box 10631

Jackson, MS 39289-0631

WATER WELL DRILLERS LOG

COUNTY WELL LOCATED  
Lincoln

WELL NUMBER 74 CODED

P-2155

DATE WELL COMPLETED  
7-5-02

PERMIT NUMBER  
057

NAME OF DRILLING FIRM  
Reeves well ser

NAME & MAILING ADDRESS OF LANDOWNER  
Gene Barkely  
Freeman Road

Latitude:  
Longitude:

WELL LOCATION. SEC 34 TOWNSHIP 5 RANGE N 7 E

DISTANCE 8 Miles DIRECTION NW of NEAREST TOWN Summit

OTHER LANDMARK

WELL PURPOSE: Home, Irrigation, Municipal, Industrial, Fish Pond, etc.

PUMP DATA

PUMP TYPE (Circle One):  
Submersible, Turbine, Jet, Flowing Well,  
Other (Describe) \_\_\_\_\_

POWER TYPE (Circle One):  
Electric, Tractor, Diesel, Gasoline, 1 Butane,  
Other (Describe) \_\_\_\_\_ H/P 2

DESCRIPTION OF FORMATIONS ENCOUNTERED	FROM	TO
<u>dirt</u>	<u>0</u>	<u>20</u>
<u>gravel</u>	<u>20</u>	<u>40</u>
<u>clay</u>	<u>40</u>	<u>50</u>
<u>sand &amp; gravel</u>	<u>50</u>	<u>70</u>

RECEIVED

AUG 05 2002

BY: OLWR

Top of Lap Pipe or Reduction in Casing

FEET IF TELESCOPED OR MORE THAN ONE SCREEN: USE BACK PAGE

WELL DATA

Well Depth 70' Casing Diameter (In.) 4" Casing Length (Ft.) 20'

Type of Casing pvc Hole Depth 70' Depth to Static Water Level 40'

TYPE OF COMPLETION: (Circle One or More):  
Gravel Packed, Underreamed, Telescoped,  
Natural Development, Open Hole, Other  
(Describe) 10 gal sand

WELL GROUTED TO A DEPTH OF 10 FEET  
Type Grout (circle one): Cement, Bentonite, or Mix

SCREEN DATA

Diameter - Inches 4" Length - Feet 10' Slot Size - Inches 10 slot

Screen Type pvc Depth to Bottom - Feet 70'

I certify that the well was drilled, constructed and completed in accordance with all applicable Requirements of the Mississippi Department of Environmental Quality and/or the Mississippi Department of Health regulations and state laws.


Jimmy Reeves 0668  
Signature of Licensed Driller and License No.

7-5-02  
Date

Additional Information Required On Back

If well telescopes please sketch and show depths.

GROUND LEVEL

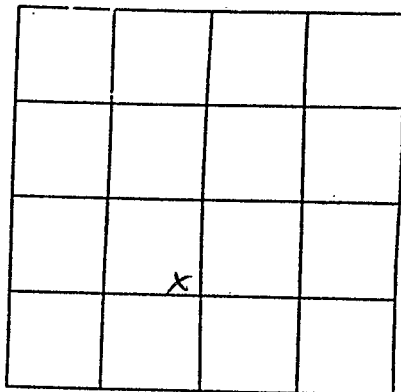

SECTION 34

Please indicate well location X.

Pump Capacity (GPM)	No. of Stages	Setting Depth
10	8	60' FT.

PUMP TEST

Well yielded 50 GPM with  
a drawdown of 0 ft.  
after 1 hours of pumping

#### LOG DATA

TYPE OF LOG RUN (Circle One): No Log Run, Electric, Gamma Ray, Density, Sonic, Neutron, Other (Describe) \_\_\_\_\_

Name of Organization Running Log \_\_\_\_\_

#### GEOLOGIC DATA (Office Use Only)

Surface Elev.	Geologic Unit	Unit Thickness	Depth to Top
Subs. SWL	Date	Analysis	Aquifer Test

Driller's Remarks

If more than one screen,  
show location of each on sketch.