

LINCOLN MISSISSIPPI BOARD OF WATER COMMISSIONERS

Q3

10-6-65

WATER WELL DRILLERS LOG

Date: Oct 6, 1965, Driller: Chertes Reeves County Lincoln  
 (Name)

(1) Owner of Land	Description & Color of Materials Sand, Clay, Red Clay, Shell, etc.	Thick- ness Feet	Depth Feet
<u>Flydd Leonard</u> (Name)	<u>Top clay</u>	<u>15</u>	<u>15</u>
<u>RFD, Bayrecho</u> (Address)	<u>Red sand</u>	<u>47</u>	<u>65</u>
(2) Location: <u>1/4</u> , <u>1/4</u> Sec. <u>18</u> T <u>5</u> R <u>9</u>	<u>Sand &amp; gravel</u>		
<u>3</u> miles <u>East</u> of <u>North</u> (distance) (direction) (Nearest Town)	<u>Red clay</u>	<u>10</u>	<u>105</u>
(3) Topography: <u>Hilly</u> (Hilly) (Flat) (Level)	<u>Clear sand</u>		
(4) Purpose of Well: <u>Domestic</u> (Domestic Irrigation Municipal, Industrial, Other)	<u>&amp; gravel</u>	<u>15</u>	<u>120</u>

Information upon completion of well:

(1) Diameter 4 inches.

(2) Total Depth 120 feet.

(3) Water Level 90 feet below top of ground.

(4) Cased to Bottom Size 4"

(5) Screen: Size 1/4", Length 7'


(6) Were any formations sealed against pollution?  
 \_\_\_\_\_ yes,  no.

CODED

If YES depth of formation \_\_\_\_\_

Why \_\_\_\_\_

Drillers Remarks: well not adequate

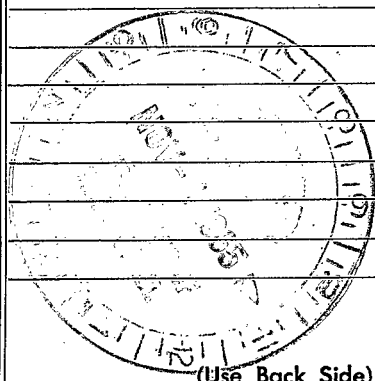

(Use Back Side)

Well No.

