

**MISSISSIPPI
BOARD OF WATER COMMISSIONERS**
416 North State Street
Jackson, Mississippi 39201

WATER WELL DRILLERS LOG

Lincoln
Q5
2-67

COVER

Feb 7 1967 REEVES Well Pump Lincoln
date well completed firm name county well located

LANDOWNER Gerald Crosby
R.F.D. 1
Bogue ch, Ho
(mailing address)

| description of formations encountered | from | to |
|---|------------|------------|
| <u>Red clay</u> | <u>0</u> | <u>18</u> |
| <u>Sand & gravel</u> | <u>18</u> | <u>35</u> |
| <u>Red clay</u> | <u>35</u> | <u>47</u> |
| <u>Sand & gravel</u> | <u>47</u> | <u>80</u> |
| <u>Red chalk</u> | <u>80</u> | <u>112</u> |
| <u>Sand & gravel mixed with chalk</u> | <u>112</u> | <u>125</u> |
| <u>pea gravel</u> | <u>125</u> | <u>134</u> |

WELL LOCATION:
sec 17 T 5 N R 8 E
3 miles E of Northfield
(distance) (direction) (nearest town)

WELL PURPOSE: Home
(home, irrigation, municipal, industrial)

WELL COMPLETION DATA:

- (1) diameter (inches) 4
- (2) total depth (feet) 134
- (3) static water level (feet) 79 below above top of ground.
- (4) casing Plastic bottom (material) (depth)
4 (size) if telescope see back,
- (5) screen 6' 128 (length) (depth to top)
4" Plastic (size) (material)
- (6) pump 3/4 Sub 15 (HP) (yield gpm)
Electric (type power)
- (7) electric log No (yes or no)
(organization running log)
- (8) how well bottom plugged Gravel


CODED

DRILLERS REMARKS: new
Home



If well telescopes please sketch and show depths.

GROUND LEVEL

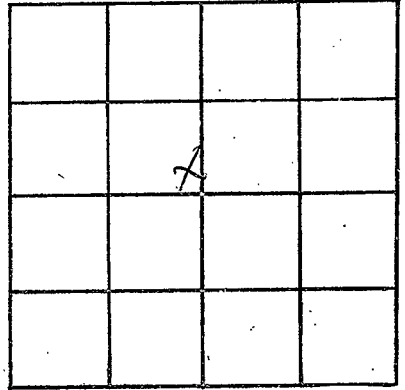

SECTION 17

Please indicate well location X.

ADDITIONAL INFORMATION

If more than one screen,
show locations of each on sketch.