

Lincoln  
 26  
 1/68

MISSISSIPPI  
 BOARD OF WATER COMMISSIONERS  
 416 North State Street  
 Jackson, Mississippi 39201

WATER WELL DRILLERS LOG

Jan 22 1968 Fitzgerald well drs Lincoln  
 date well completed CODED firm name county well located

LANDOWNER:  
Shady Grove Church  
RR Bogue Chitto miss.  
 (mailing address)

description of formations encountered	from	to
Red clay	0	15
Thin white sand	15	62
Blue chalk	62	162
Coarse sand	162	175
Coarse sand & gravel	175	186


WELL LOCATION:  
 sec. 23 T. 5 N. R. 8 E.  
 S W  
10 miles NE of Summit  
 (distance) (direction) (nearest town)

WELL PURPOSE: Home  
 (home, irrigation, municipal, industrial)

- WELL COMPLETION DATA:
- (1) diameter (inches) 4
  - (2) total depth (feet) 186'
  - (3) static water level (feet) 50 below above top of ground.
  - (4) casing Plastic 180'  
 (material) (depth)  
4" if telescope see back.  
 (size)
  - (5) screen 6" 180'  
 (length) (depth to top)  
4" Plastic  
 (size) (material)
  - (6) pump 1 6  
 (HP) (yield gpm)  
Electric  
 (type power)
  - (7) electric log no  
 (yes or no)  
 (organization running log)
  - (8) how well bottom plugged Good per

CODED


CODED

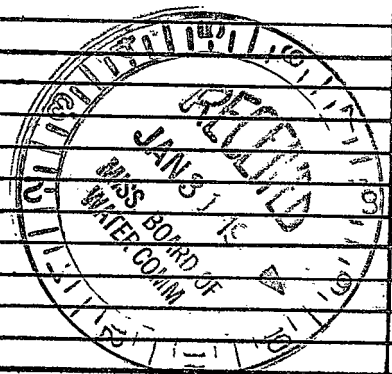

DRILLERS REMARKS:

If well telescopes please sketch and show depths.

GROUND LEVEL

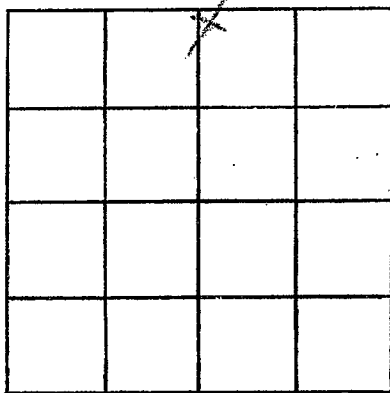

SECTION 23

Please indicate well location X.

ADDITIONAL INFORMATION

If more than one screen, show locations of each on sketch.