

CODED

Lincoln
Q8
5-68

MISSISSIPPI
BOARD OF WATER COMMISSIONERS
416 North State Street
Jackson, Mississippi 39201

WATER WELL DRILLERS LOG

5-30 1968 Fitzgibbon Inc Lincoln
date well completed firm name county well located

LANDOWNER: Ralph McCallum

description of formations encountered	from to	
	ft	ft
<u>Red clay</u>	<u>0</u>	<u>15</u>
<u>Red sand</u>	<u>15</u>	<u>60</u>
<u>Coarse sand & gravel</u>	<u>60</u>	<u>90</u>
<u>Fine sand</u>	<u>90</u>	<u>100</u>
<u>sand & gravel</u>	<u>100</u>	<u>108</u>

RR. Summit, Miss.
(mailing address)

WELL LOCATION:
sec. 36 T. 5 N. R. 8 E.
10 miles E of Summit
(distance) (direction) (nearest town)

WELL PURPOSE: Home
(home, irrigation, municipal, industrial)

WELL COMPLETION DATA:

- (1) diameter (inches) 4"
- (2) total depth (feet) 108'
- (3) static water level (feet) 70 below above top of ground.
- (4) casing Refric, 102'
(material) (depth)
4" if telescope see back.
(size)
- (5) screen 6", 102'
(length) (depth to top)
4", plastic
(size) (material)
- (6) pump 3, 3
(HP) (yield gpm)
Electric
(type power)
- (7) electric log No
(yes or no)

(organization running log)
- (8) how well bottom plugged wood pc.


CODED

JUL 11 5 10 PM '68
MISS. BOARD OF
WATER COMMISSIONERS

DRILLERS REMARKS:

If well telescopes please sketch and show depths.

GROUND LEVEL

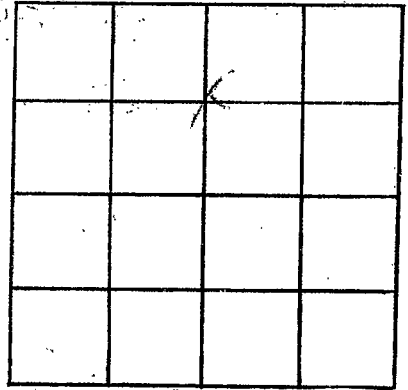

SECTION

36

Please indicate well location X.

ADDITIONAL INFORMATION

If more than one screen,
show locations of each on sketch.