

LINCOLN MISSISSIPPI BOARD OF WATER COMMISSIONERS

R Q 11 CODED CODED CODED CODED

OK'd 10/17/68
300

10-26-60 CODED CODED WATER WELL DRILLERS LOG

Date: 10-26, 1960, Driller: Chester Reeves County Lincoln
(Name)

(1) Owner of Land: Oscar Cole
(Name)
PFD - Ruth Rt 1
(Address)
(2) Location: 1/4, 1/4, Sec. 36 T5 R8
5 miles S.E. of Ruth
(distance) (direction) (Nearest Town)
(3) Topography: Level
(Hilly) (Flat) (Level)
(4) Purpose of Well: Domestic
(Domestic Irrigation
Municipal, Industrial, Other)

Description & Color of Materials Sand, Clay, Red Clay, Shell, etc.	Thick- ness Feet	Depth Feet
clay	10	10
sand & Gravel	41	51
CODED		
CODED		
CODED		
CODED		


Information upon completion of well CODED

(1) Diameter 4 inches.
(2) Total Depth 51 feet.
(3) Water Level 26 feet below top of ground.
(4) Cased to Bottom, Size 4"
(5) Screen: Size NONE, Length _____
(6) Were any formations sealed against pollution?
yes, no.

CODED
Cannot locate.
Pump does not agree
with depth of well or dist.
OK

REEVES WELL AND PUMP CO.
Phone 1250
McCOMB, MISSISSIPPI

If YES depth of formation _____
Why _____
Drillers Remarks: CODED

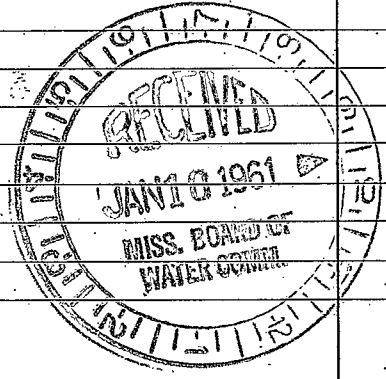

(Use Back Side)

Well No.

