

CODED

MISSISSIPPI BOARD OF WATER COMMISSIONERS  
416 North State Street  
Jackson, Mississippi 39201

WATER WELL DRILLERS LOG

Lincoln  
Q 12  
8-68

Aug 31 1968 Reeves Well Pump Co. Lincoln  
date well completed firm name county well located

LANDOWNER: Mark  
Razuls  
R.F. Borechitto  
(mailing address)

description of formations encountered	from	to
red clay	0	17
red sand	22	48
sand rock	48	49
brown sand gravel	49	60
brown sand	60	100
pea gravel	100	105
red chalk	105	110
pea gravel	110	127

WELL LOCATION:  
sec. 14 T 5 N R 8 E  
3 miles WNW of Ruth  
(distance) (direction) (nearest town)

WELL PURPOSE: Home  
(home, irrigation, municipal, industrial)

WELL COMPLETION DATA:  
(1) diameter (inches) 4"  
(2) total depth (feet) 127  
(3) static water level (feet) 48 below top of ground.  
(4) casing plastic ballast (material) (depth)


(5) screen 6' 17' (length) (depth to top)  
4" plastic (size) (material)

(6) pump 1/3 HP (type power)  
from old well (yield gpm)

(7) electric log no (yes or no)  
(organization running log)


(8) how well bottom plugged  
wooden plug

DRILLERS REMARKS:  
old well bad

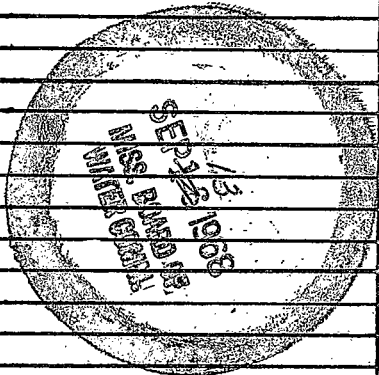

If well telescopes please sketch and show depths.

GROUND LEVEL

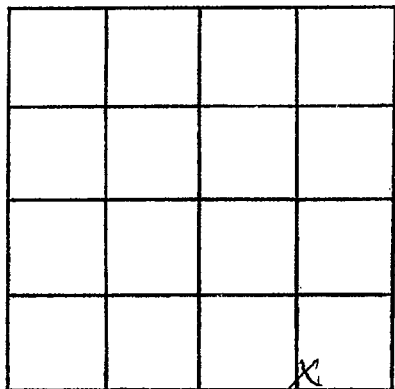

SECTION 14

Please indicate well location X.

ADDITIONAL INFORMATION

If more than one screen, show locations of each on sketch.