

100-

Lincoln
Q 13
8-68

MISSISSIPPI
BOARD OF WATER COMMISSIONERS
416 North State Street
Jackson, Mississippi 39201

WATER WELL DRILLERS LOG

Aug 20 1968 Reynolds & Kump Lincoln
date well completed firm name county well located

LANDOWNER: Robert L. Crosby
M. C. Lamb
(mailing address)

| description of formations encountered | from | to |
|---------------------------------------|------|-----|
| Red clay & gravel | 0 | 3.5 |
| Red Sand & gravel | 3.5 | 62 |
| Red cherty sand | 62 | 80 |
| fine Red Sand | 80 | 106 |

WELL LOCATION:
sec 30 T S N R 8 E
3 1/2 miles SE of Madison
(distance) (direction) (nearest town)

WELL PURPOSE: drain
(home, irrigation, municipal, industrial)


WELL COMPLETION DATA:
(1) diameter (inches) 4"
(2) total depth (feet) 106
(3) static water level (feet) 68 below above top of ground.
(4) casing Plastic bottom
(material) (depth)

6' if telescope see back.
(size)
(5) screen 6' 100
(length) (depth to top)
4" Plastic
(size) (material)

(6) pump owner installed
owner purchased
(type power)
(7) electric log no
(yes or no)


(organization running log)
(8) how well bottom plugged wooden plug

DRILLERS REMARKS:
no response well

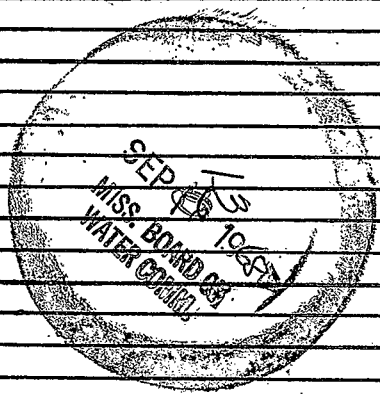

If well telescopes please sketch and show depths.

GROUND LEVEL

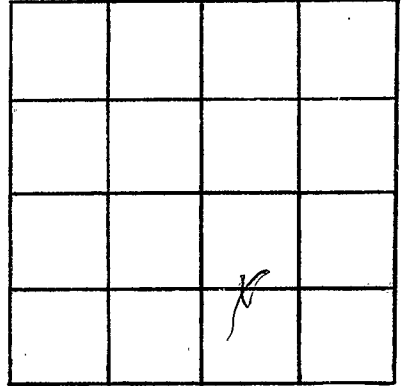

SECTION 30

Please indicate well location X.

ADDITIONAL INFORMATION

If more than one screen,
show locations of each on sketch.