

MISSISSIPPI
BOARD OF WATER COMMISSIONERS
416 North State Street
Jackson, Mississippi 39201

WATER WELL DRILLERS LOG

Lincoln
Q 14
11-1-68

Nov. 1 1968 date well completed
G.S. Reeves Well Drilling Co. - Lincoln firm name
Lincoln county well located

LANDOWNER: Dale Taylor
RFD Bayoucutts
(mailing address)

description of formations encountered	from	to
Red Sandy clay	0	30
Red Sand	30	65
Chalky sand & gravel	65	87
small gravel	87	93

WELL LOCATION:
sec. 14 T5 N R. 8 E
6 miles E Nonfield
(distance) (direction) (nearest town)

WELL PURPOSE: Farm Use
(home, irrigation, municipal, industrial)

- WELL COMPLETION DATA:
- (1) diameter (inches) 4"
 - (2) total depth (feet) 93
 - (3) static water level (feet) 57 below top of ground.
 - (4) casing Plastic Bathum (material) (depth)
 - (5) screen 6' 87' (length) (depth to top)
 - 4" Plastic (size) (material)
 - (6) pump 1/2 Sub 12 (HP) (yield gpm)
 - Direct (type power)
 - (7) electric log No (yes or no)

(organization running log)

(8) how well bottom plugged wooden plug


DRILLERS REMARKS:
no previous well

DEC 13 1968

MISS. Bd. OF
WATER COMM.

If well telescopes please sketch and show depths.

GROUND LEVEL

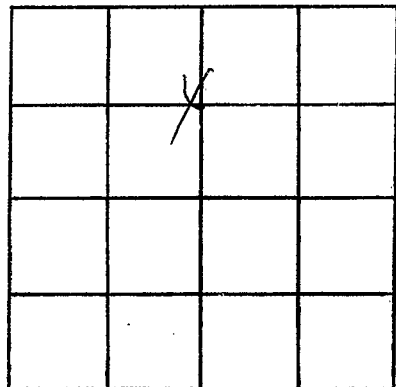

SECTION 14

Please indicate well location X.

ADDITIONAL INFORMATION

If more than one screen, show locations of each on sketch.