

Lincoln
Q 15
10-23-68

MISSISSIPPI
BOARD OF WATER COMMISSIONERS
416 North State Street
Jackson, Mississippi 39201

CODED

WATER WELL DRILLERS LOG

Oct 23 1968 Keener Well Drilling Co. Lincoln
date well completed firm name county well located

LANDOWNER: Melvin
Watters -
P.O. Box 4110
(mailing address)

description of formations encountered	from	to
Red clay	0	18
Red sand and shell	18	72
gravel & shell	72	90
Red chalk	90	112
Small Red gravel sand	112	135

WELL LOCATION:
sec. 17 T. 5 N R. 8 E
3 miles E-SE of ~~Northfield~~
(distance) (direction) (nearest town)

WELL PURPOSE: Home -
(home, irrigation, municipal, industrial)

- WELL COMPLETION DATA:
- (1) diameter (inches) 4"
 - (2) total depth (feet) 135
 - (3) static water level (feet) 75 below top of ground.
 - (4) casing Plastic batons (material) (depth)
 - (5) screen 6' (length) 120' (depth to top)
4" (size) Plastic (material)
 - (6) pump 3/4" (HP) 13 (yield gpm)
Electric (type power)
 - (7) electric log NO (yes or no)

(organization running log)

(8) how well bottom plugged
Wooden plug


DRILLERS REMARKS:
New house -

DEC 13 1968

Miss. Bd. of
Water Comm.
1968-69

If well telescopes please sketch and show depths.

GROUND LEVEL

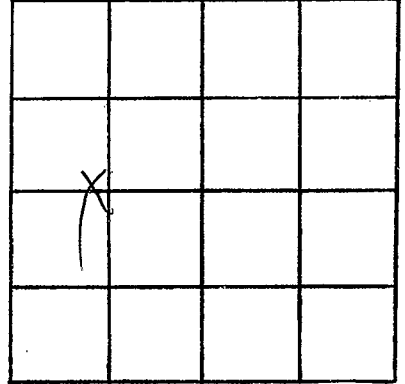

SECTION 17

Please indicate well location X.

ADDITIONAL INFORMATION

If more than one screen, show locations of each on sketch.