

Lincoln Co.  
 Q17  
 6-69

MISSISSIPPI  
 BOARD OF WATER COMMISSIONERS  
 416 North State Street  
 Jackson, Mississippi 39201 **CODED**

WATER WELL DRILLERS LOG

6-25 1969 Fitzgerald well dr Lincoln  
 date well completed firm name county well located

LANDOWNER:  
Murphy Price  
R.R. Bogue Chitto  
 (mailing address)

WELL LOCATION:  
 sec. 20 T 5N R 8E  
7 miles NE of Summit  
 (distance) (direction) (nearest town)

WELL PURPOSE:  
Home  
 (home, irrigation, municipal, industrial)

WELL COMPLETION DATA:  
 (1) diameter (inches) 4  
 (2) total depth (feet) 92  
 (3) static water level (feet) 50 below above top of ground. **CODED**  
 (4) casing Plaster 86,  
 (material) (depth)  
4 if telescope see back.  
 (size)  
 (5) screen 6 86'  
 (length) (depth to top)  
4, Plaster  
 (size) (material)  
 (6) pump 3/4 C  
 (HP) (yield gpm)  
Elco  
 (type power)  
 (7) electric log No  
 (yes or no)  
 (organization running log)

description of formations encountered	from	to
Red Clay	0	20
Red sand	20	50
Red gravel	50	55
White clay	55	85
Coarse sand	85	92


(8) how well bottom plugged covered

DRILLERS REMARKS:

**NOV 4 1969**  
 MISS. BD. OF  
 WATER COMMISSIONERS

If well telescopes please sketch and show depths.

GROUND LEVEL

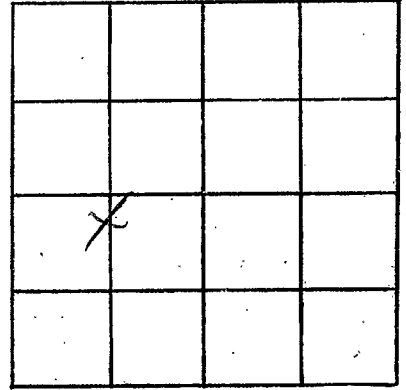

SECTION 20

Please indicate well location X.

ADDITIONAL INFORMATION

If more than one screen, show locations of each on sketch.