

MISSISSIPPI
BOARD OF WATER COMMISSIONERS
416 North State Street
Jackson, Mississippi 39201

Lincoln

Lincoln

5-20-70

Q 19 3

BD WATER WELL DRILLERS LOG

20 May
date well completed

1970 J.T. Covington & Son
firm name

county well located

LANDOWNER:

Jimmy Hux
Summit
(mailing address)

description of formations encountered

from to

<i>clay</i>	<i>0</i>	<i>20</i>
<i>clay sand</i>	<i>20</i>	<i>35</i>
<i>chalk sand</i>	<i>35</i>	<i>50</i>
<i>sand gravel</i>	<i>50</i>	<i>80</i>

WELL LOCATION:

sec. *20* T. *5* N. R. *8* E *168*
S W
8 miles *West* of *Summit*
(distance) (direction) (nearest town)

WELL PURPOSE:

(home, irrigation, municipal, industrial)

WELL COMPLETION DATA:

- (1) diameter (inches) *4*
- (2) total depth (feet) *80*
- (3) static water level (feet) *60* below above top of ground.
- (4) casing *PI* *7K*
(material) (depth)
(size) if telescope see back.
- (5) screen *16* *74*
(length) (depth to top)
4 *PI*
(size) (material)
- (6) pump *4* *10*
(HP) (yield gpm)
Elect
(type power)
- (7) electric log (yes or no)

(organization running log)

(8) how well bottom plugged *Wood*


JUN 5 1970

DRILLERS REMARKS:

MISS. BD. OF
WATER COMMISSIONERS

If well telescopes please sketch and show depths.

GROUND LEVEL

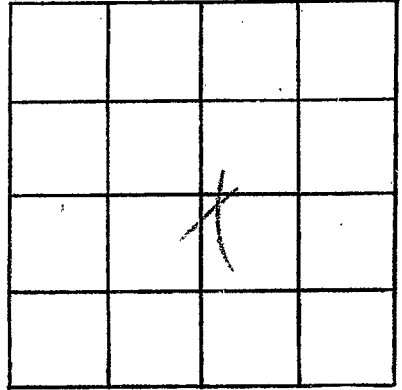

SECTION 20

Please indicate well location X.

ADDITIONAL INFORMATION

If more than one screen, show locations of each on sketch.