

LINCOLN
Q 20
7-24-70

MISSISSIPPI
BOARD OF WATER COMMISSIONERS
416 North State Street
Jackson, Mississippi 39201

CODED

WATER WELL DRILLERS LOG

7-24 1970
date well completed

Fitzgerald well serv
firm name

Lincoln
county well located

LANDOWNER:
Jack S. Rawls
R.R. Bagnicetto
(mailing address)

description of formations encountered	from	to
Red clay	0	15
Red sand	15	70
white clay	40	90
fine sand	90	110
coarse sand	110	124

WELL LOCATION:
sec. 19 T 5 N R 8 E W 8 N 5 m
3 miles North of Summit
(distance) (direction) (nearest town)

WELL PURPOSE: Home
(home, irrigation, municipal, industrial)

- WELL COMPLETION DATA:
- (1) diameter (inches) 4
 - (2) total depth (feet) 124
 - (3) static water level (feet) 85 below above top of ground.
 - (4) casing Plastic, 116, (material) (depth)
4 (size) if telescope see back.
 - (5) screen 8, 116 (length) (depth to top)
4 (size) Plastic (material)
 - (6) pump 3/4, 6 (HP) (yield gpm)
Ela (type power)
 - (7) electric log 74 (yes or no)
(organization running log)
 - (8) how well bottom plugged drilled

CODED


AUG 17 1970

DRILLERS REMARKS:

AMCO, INC.
WATER

If well telescopes please sketch and show depths.

GROUND LEVEL

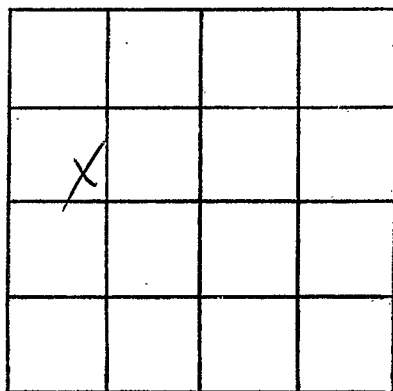

SECTION 19

Please indicate well location X.

ADDITIONAL INFORMATION

If more than one screen,
show locations of each on sketch.