

LINCOLN  
Q 21  
7-7-66

MISSISSIPPI BOARD OF WATER COMMISSIONERS

CODED

WATER WELL DRILLERS LOG

LINCOLN

Date: 7 July, 1966, Driller: J. T. Cornington Sou County ~~Miss~~  
(Name)

(1) Owner of Land: Linton Cavert  
(Name)  
Summit, Miss.  
(Address)

(2) Location: NE 1/4, 1/4, Sec. 30 T15 R8<sup>NE</sup>  
8 miles North, of Summit  
(distance) (direction) (Nearest Town)

(3) Topography: ✓  
(Hilly) (Flat) (Level)

(4) Purpose of Well: Domestic  
(Domestic Irrigation, Municipal, Industrial, Other)

Description & Color of Materials Sand, Clay, Red Clay, Shell, etc.	Thick-ness Feet	Depth Feet
<u>Clay</u>	<u>30</u>	
<u>Sand &amp; Gravel</u>	<u>45</u>	<u>65</u>

Information upon completion of well:

(1) Diameter 4" inches.

(2) Total Depth 65 feet.

(3) Water Level 40 feet below top of ground.

(4) Cased to 65ft, Size 4".


(5) Screen: Size 4", Length 6'.

(6) Were any formations sealed against pollution?  
   yes, ✓ no.

If YES depth of formation \_\_\_\_\_  
Why \_\_\_\_\_

Drillers Remarks: \_\_\_\_\_

CODED

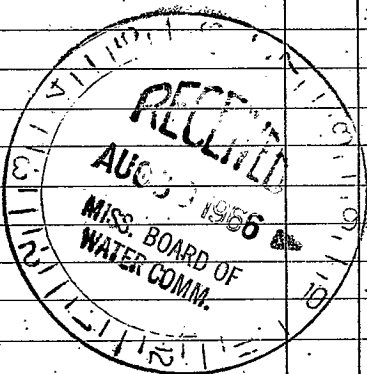

(Use Back Side)

Well No.

