

LINCOLN  
Q 22  
4-9-71

MISSISSIPPI  
BOARD OF WATER COMMISSIONERS  
416 North State Street  
Jackson, Mississippi 39201

**CODED**

WATER WELL DRILLERS LOG

April 9, 1971 Chestnut Keenes Lincoln  
date well completed firm name county well located

LANDOWNER: Sal Rawls  
RFD -  
Boque Clutto  
(mailing address)

description of formations encountered	from	to
Red clay	0	12
Red sand	12	60
Red chalk	60	75
Small gravel sand	75	91

WELL LOCATION:  
sec. 14 T. 5 N R. 8 E  
4 miles NW of Ruth  
(distance) (direction) (nearest town)

WELL PURPOSE: Drain  
(home, irrigation, municipal, industrial)

WELL COMPLETION DATA:

(1) diameter (inches) 4"

(2) total depth (feet) 91

(3) static water level (feet) 60 below top of ground above

(4) casing Plast. battery  
(material) (depth)

(size) If telescope see back.

(5) screen 6' 85'  
(length) (depth to top)

4" Plast.  
(size) (material)

(6) pump summersold  
(HP) (rated gpm)

summersold  
(type power)

(7) electric log No.  
(yes or no)

(organization running log)

**CODED**

(8) how well bottom plugged wooden plug


DRILLERS REMARKS:  
old well dry

MAY 20 1971

MISS. Bd. OF  
WATER COMMISSIONERS

If well telescopes please sketch and show depths.

GROUND LEVEL

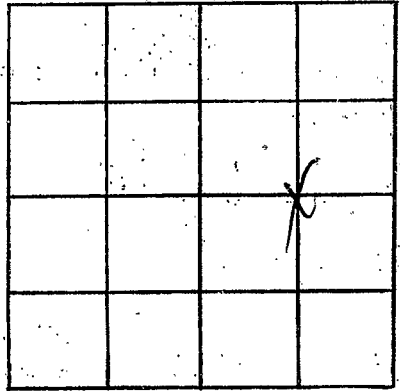

SECTION 14

Please indicate well location X.

ADDITIONAL INFORMATION

If more than one screen, show locations of each on sketch.