

Lincoln
Q25
2-17-72

MISSISSIPPI
 BOARD OF WATER COMMISSIONERS
 416 North State Street
 Jackson, Mississippi 39201

CODED


WATER WELL DRILLERS LOG

17 Feb 1972 J. T. Armstrong Lincoln
 date well completed firm name county well located

LANDOWNER:	description of formations encountered	from	to
<u>Mark's Creep Crack</u> <u>Robert Curtis</u> (mailing address)	<u>clay</u> <u>hard clay</u> <u>rock</u>	<u>0</u> <u>15</u> <u>35</u>	<u>15</u> <u>35</u> <u>85</u>
WELL LOCATION: sec. <u>30</u> T. <u>5</u> N R. <u>8</u> E <u>6</u> miles <u>East</u> of <u>B.C.</u> (distance) (direction) (nearest town)			
WELL PURPOSE: (home, irrigation, municipal, industrial)			
WELL COMPLETION DATA: (1) diameter (inches) <u>4</u> (2) total depth (feet) <u>85 ft</u> (3) static water level (feet) <u>60</u> below above top of ground. (4) casing <u>PI</u> <u>79</u> (material) (depth) _____ if telescope see back. (size) (5) screen <u>6</u> <u>79</u> (length) (depth to top) <u>4</u> <u>PI</u> (size) (material) (6) pump <u>1/2</u> <u>8</u> (HP) (yield gpm) <u>elect.</u> (type power) (7) electric log _____ (organization running log) (8) how well bottom plugged <u>used</u>	<p style="text-align: center;">CODED</p>	<p style="text-align: center;">APR 7 1972</p>	
DRILLERS REMARKS:	MISS. BD. OF WATER COMM.		

If well telescopes please sketch and show depths.

GROUND LEVEL

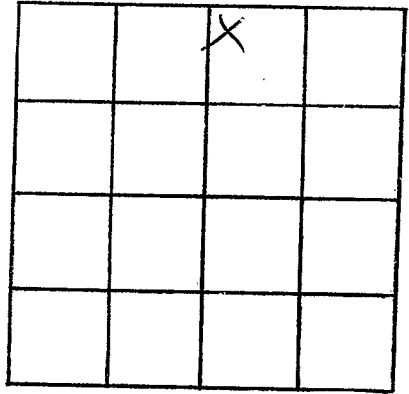

SECTION 30

Please indicate well location X.

ADDITIONAL INFORMATION

Lined area for additional information.

If more than one screen, show locations of each on sketch.