

Lincoln  
Q27  
4-21-72

MISSISSIPPI  
 BOARD OF WATER COMMISSIONERS  
 416 North State Street  
 Jackson, Mississippi 39201

**CODED**

WATER WELL DRILLERS LOG

April 21 1972 Green water well cont. Lincoln  
 date well completed firm name county well located

LANDOWNER: Pleasant Hill Baptist Church, Parsonage  
Rt 2 Box 204 Bogumchitto  
 (mailing address)

description of formations encountered	from	to
<u>clay and sand &amp; gravel</u>	<u>0</u>	<u>95</u>

WELL LOCATION:  
 sec 2 T 5 N R 8 E  
13 miles S of Bogumchitto  
 (distance) (direction) (nearest town)

WELL PURPOSE: home  
 (home, irrigation, municipal, industrial)

- WELL COMPLETION DATA:
- (1) diameter (inches) 6"
  - (2) total depth (feet) 95
  - (3) static water level (feet) 53 below above top of ground.
  - (4) casing PVC, 80'  
 (material) (depth)  
4" if telescope see back.  
 (size)
  - (5) screen 6', 80'  
 (length) (depth to top)  
1.010, PVC  
 (size) (material)
  - (6) pump did not install  
 (HP) (yield gpm)
  - (type power)
  - (7) electric log no  
 (yes or no)
  - (organization running log)
  - (8) how well bottom plugged wood

**CODED**

JUN 10 1972


DRILLERS REMARKS:

MISS. Bd. of WATER COMMISSIONERS

②

If well telescopes please sketch and show depths.

GROUND LEVEL

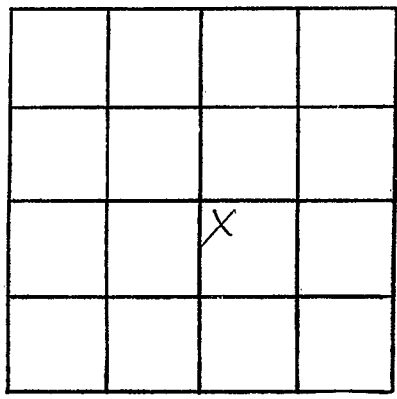

SECTION 2

Please indicate well location X.

ADDITIONAL INFORMATION

Lined area for additional information.

If more than one screen, show locations of each on sketch.