

LINCOLN
Q28
4-12-72

MISSISSIPPI
 BOARD OF WATER COMMISSIONERS
 416 North State Street
 Jackson, Mississippi 39201

WATER WELL DRILLERS LOG

CODED

12 April 1972 *S. H. Waterfield* *Windsor*
 date well completed firm name county well located

LANDOWNER:	description of formations encountered	from	to
<i>Franklin Mack</i>			
(mailing address)	<i>Clay</i>	<i>0</i>	<i>12</i>
WELL LOCATION:	<i>Clay shale</i>	<i>12</i>	<i>35</i>
sec. <i>5</i> T. <i>5</i> N. R. <i>8</i> E	<i>Sand & shale</i>	<i>35</i>	<i>60</i>
<i>2</i> miles <i>East</i> of <i>Bay City</i>	<i>Gravel</i>	<i>60</i>	<i>95</i>
WELL PURPOSE: (home, irrigation, municipal, industrial)			
WELL COMPLETION DATA:			
(1) diameter (inches) <i>4</i>			
(2) total depth (feet) <i>95</i>			
(3) static water level (feet) <i>65</i> below top of ground.			
(4) casing <i>PI</i> <i>89</i> (material) (depth)			
_____ if telescope see back. (size)			
(5) screen <i>6</i> <i>89</i> (length) (depth to top)			
<i>4</i> _____ (size) (material)			
(6) pump <i>1/2</i> <i>8</i> (HP) (yield gpm)			
<i>Electric</i> (type power)			
(7) electric log _____ (yes or no)			
_____ (organization running log)			
(8) how well bottom plugged <i>used</i>			
DRILLERS REMARKS:			


CODED

APR 16 1972

MISSISSIPPI
 BOARD OF WATER COMMISSIONERS
 JACKSON, MISSISSIPPI

If well telescopes please sketch and show depths.

GROUND LEVEL

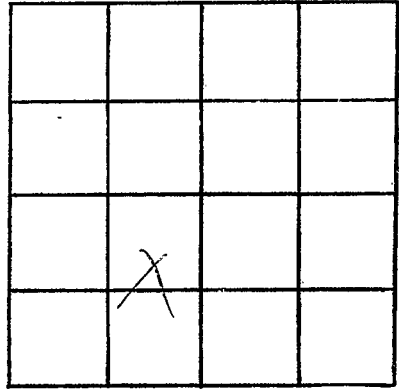

SECTION 5

Please indicate well location X.

ADDITIONAL INFORMATION

If more than one screen,
show locations of each on sketch.